IREDELL COUNTY HEALTH DEPARTMENT

STATESVILLE 704-878-5305 (ei) MOORESVILLE 704-664-5281

IMPROVEMENT PERMIT / AUTHORIZATION TO CONSTRUCT / OPERATION PERMIT / EXISTING SYSTEM INSPECTION

PERMIT# ~~TROUTMAN~~ 11164 PIN# 4731-30-~~9134~~ 6424 DATE 10-25-02

OWNER OR CONTRACTOR ANTHONY RAY PINION PHONE: Business _____ Home 704-528-9998

ADDRESS P.O. BOX 883 TROUTMAN NC 28166

LOCATION US 21 SOUTH, TR TALLEY ROAD, TL LYTTON FARM ROAD, TL PINION POND DRIVE 200' ON RIGHT

SUBDIVISION PINION BLOCK / SECTION _____ LOT 1 LOT AREA 1.091 ACRES SITE CLASS PS DESIGN FLOW 480 L.T.A.R. 0.30 GPD/FT²

Septic Tank: 1000 Gallons; STB 312 Date 1-27-03
Pump Tank: _____ Gallons; PT _____ Date _____
Pump Make: _____ Model _____ Serial No. _____
Nitrification Field: No Fields 1 Square Feet 1600 Linear Feet 540
No Lines SIX Trench Width 36" Max Trench Bottom Depth 36" Gravel Depth 12"

☑ New System ☐ Repair System Type: I (II) III. IV. V. VI
System Description: CONVENTIONAL GRAVITY
Repair System Description: 50% REDUCTION, GRAVITY
Maintenance Agreement Required: ☐ Yes ☑ No


☑ House/Mod. Home No. Bedrooms 4
☐ Mobile Home No. Bathrooms 3
☐ Business No. Employees _____
☐ Other _____
☐ Slab ☑ Crawl Space ☐ Basement w/plumbing ☐ Basement wo/plumbing

Water Supply: ☑ Individual ☐ Public ☐ Community
WELL

Comments:/Conditions: KEEP SYSTEM MINIMUM 100 FEET FROM WELL

Comments:/Conditions: SEPTIC TANK WITH MARKER INSTALLED USING "ZABEL" FILTER

INITIAL SITE SKETCH

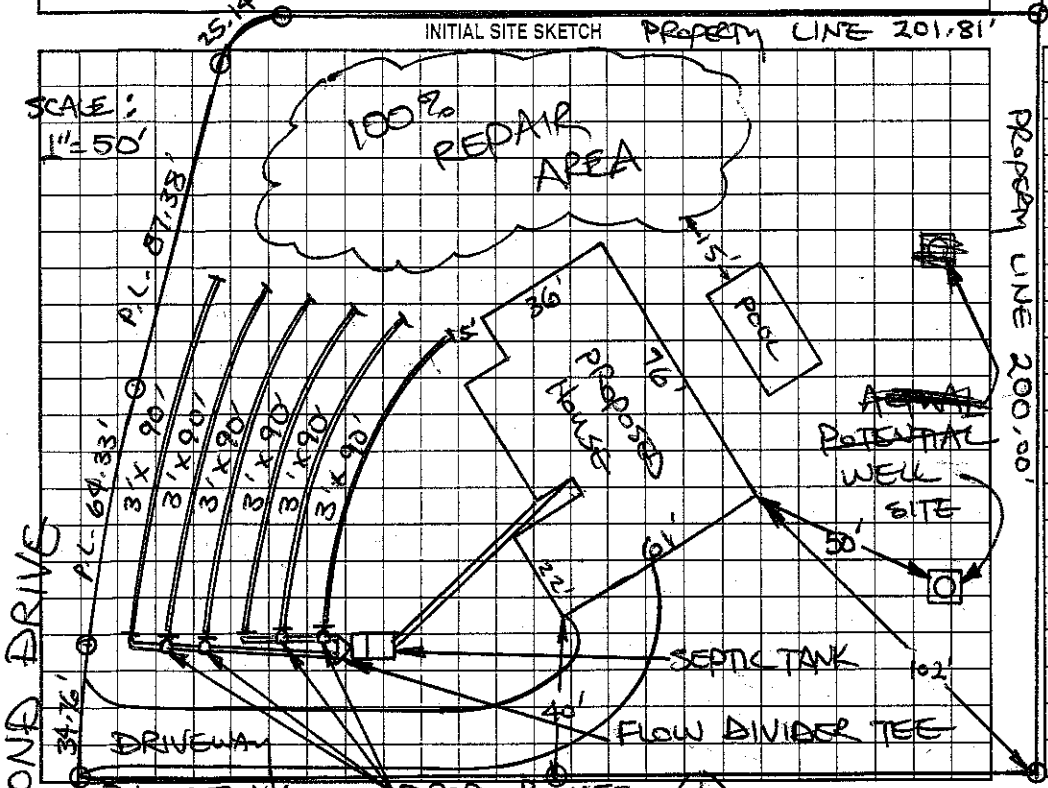

AS BUILT SKETCH

SEPTIC SYSTEM INSTALLED ACCORDING TO INITIAL SITE SKETCH

Permit can be suspended or revoked if any false information is supplied toward securing the permit/any unauthorized changes are made to the site/any unauthorized changes are made in the installation of the system. Improvement Permit with plat valid without expiration. Improvement Permit with site plan valid for sixty months. Authorization to Construct is valid for a period equal to that of Improvement Permit – not to exceed sixty months.

Signed: Cynthia Pinion date 10-25-02 Installed by: MARTY TUCKER

Improvement Permit by: STEVE HEDRICK date 10-25-02 Operation Permit by: STEVE HEDRICK date 9-3-03

Authorization to Construct by: STEVE HEDRICK date 10-25-02 Existing System Inspection by: _____ date _____

HEALTH DEPT. COPY: WHITE OWNER COPY (FINAL): YELLOW OWNER COPY (INITIAL): PINK