IREDELL COUNTY HEALTH DEPARTMENT

STATESVILLE 704-878-5305 MOORESVILLE ~~704-664-5281~~

IMPROVEMENT PERMIT / AUTHORIZATION TO CONSTRUCT / OPERATION PERMIT / EXISTING SYSTEM INSPECTION

PERMIT # 161890 PIN # ~~4731-40-4690~~ 30-6945 DATE 11 June 10

OWNER or APPLICANT Marty Moose / America's Hunting Heritage PHONE: Business (704) 872-4400 Home:

OWNER or APPLICANT ADDRESS 207 Lytton Farm Rd. Troutman, NC.

LOCATION / DIRECTIONS Hwy 21 Turn onto Talley St. TL Lytton Farm Rd House on the left.

SUBDIVISION BLOCK / SECTION LOT # LOT AREA 1.7 Ac. DESIGN FLOW 360 gpd L.T.A.R.

Exist

Septic Tank 1000 Gallons: STB Date

Pump Tank Gallons: P T Date

Pump Make Model Exist. Serial #

Nitrification Field No Fields No Lines 3 Linear Feet 240

Trench Width Max. Trench Bottom Depth Exist. Gravel Depth 12"

☐ New System ☐ Repair ☐ Expansion System Type I II III IV V VI

System Description: Conventional / -exist.

Repair System Description:

Maintenance Agreement Required ☐ YES ☑ NO

☑ GRAVITY ☐ PRESSURE

☑ Residence No. Bedrooms 3

☐ Business No. Persons

☐ Other No. Employees

☐ Slab ☑ Crawl Space

☐ Basement w/plumbing ☐ Basement w/o plumbing


Water Supply: ☑ Private ☐ Public ☐ Community

Comments / Conditions

Comments / Conditions

INITIAL SITE SKETCH

AS BUILT SKETCH

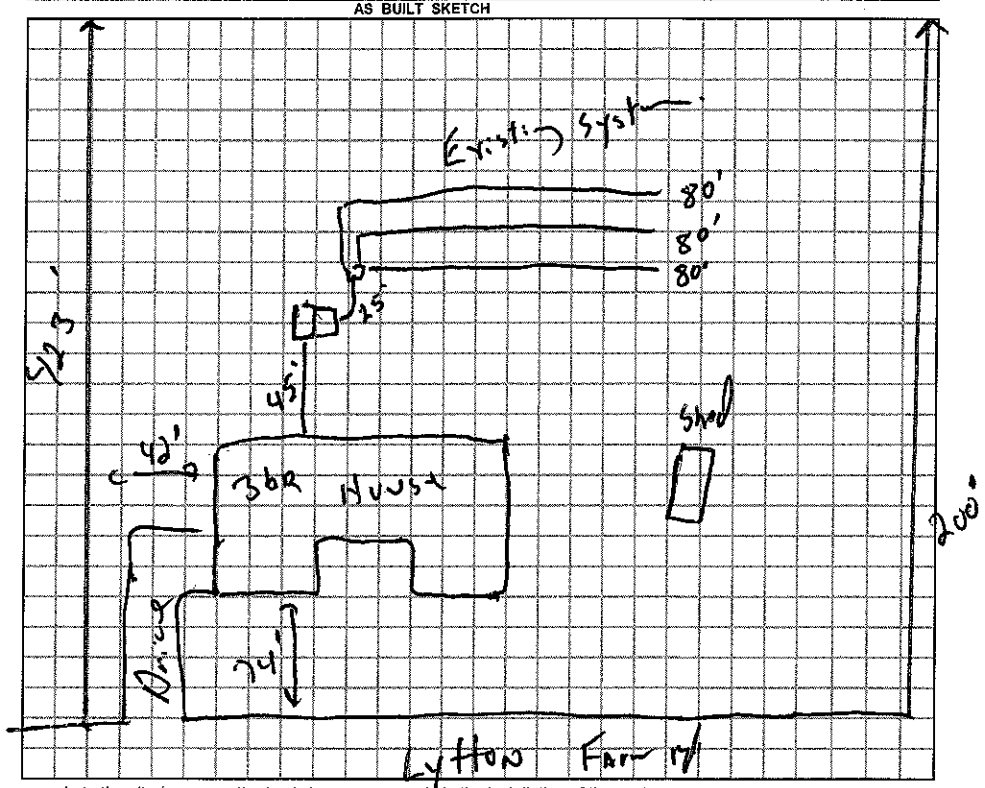

Permit can be suspended or revoked if any false information is supplied toward securing the permit / any unauthorized changes are made to the site / any unauthorized changes are made in the installation of the system.

☐ *IMPROVEMENT PERMIT w / plat valid without expiration.* ☐ *IMPROVEMENT PERMIT w / site plan valid for 60 mos.* ☐ *AUTHORIZATION TO CONSTRUCT valid for period equal to IMPROVEMENT PERMIT-not to exceed 60 mo.*

Owner / Applicant Signature: Date

Improvement Permit by: Date

Authorization to Construct by: Date

YOU SHOULD CONTACT A LOCATOR SERVICE PRIOR TO ANY EXCAVATION.

Installed by:

Operation Permit by: Date:

Existing System Inspected by: R.S. Date: 11 June 10

WHITE COPY Environmental Health YELLOW COPY (Final) Owner / Applicant PINK COPY (Initial) Owner / Applicant