IREDELL COUNTY HEALTH DEPARTMENT - *ENVIRONMENTAL HEALTH* ☑ STATESVILLE OFFICE 704-878-5305 ☐ MOORESVILLE OFFICE 704-664-5281

IMPROVEMENT PERMIT / AUTHORIZATION TO CONSTRUCT / OPERATION PERMIT / EXISTING SYSTEM INSPECTION

PERMIT # 175784 PIN # 4731307730 DATE 11-8-12

OWNER Ray Pinion APPLICANT: America's Home Place PHONE: Home/Cell # 704-872-4400 Business # N/A

SITE ADDRESS 215 Lytton Farm Rd. OWNER / APPLICANT ADDRESS PO Box 1096 Troutman

SITE DIRECTIONS Hwy 215 TR Talley Rd. TL Lytton Farm Rd. Lot at Corner of Lytton Farm & Pinion Pond

SUBDIVISION Ray Lee Pinion BLOCK / SECTION N/A LOT # TR3 LOT AREA 1.577 acres DESIGN FLOW 360 gpd L.T.A.R. 0.25

Septic Tank 1000 Gallons: STB 760 Date 8-24

Pump Tank ____ Gallons: P T ____ Date ____

Pump Make ____ Model ____ Serial # ____

No. Nitrification Fields: 1 No. Lines 5 Linear Feet 360

Trench Width 36" Max. Trench Bottom Depth 36" Gravel Depth N/A

☑ New System ☐ Repair ☐ Expansion System Type I II III IV V VI

System Description: 25% Reduction

Repair System Description: 25% Reduction

Maintenance Agreement Required ☐ YES ☑ NO

☑ GRAVITY ☐ PRESSURE

☑ Residence No. Bedrooms 3

☐ Business No. Persons ____

☐ Other No. Employees ____


☑ Slab ☐ Crawl Space

☐ Basement w/plumbing ☐ Basement w/o plumbing


Water Supply: ☑ Private ☐ Public ☐ Community

Comments / Conditions: Install a 25% Reduction system on contour with serial distribution. Well area is +100' from all component of septic system. Grade out terrace at tree line.

INITIAL SITE SKETCH

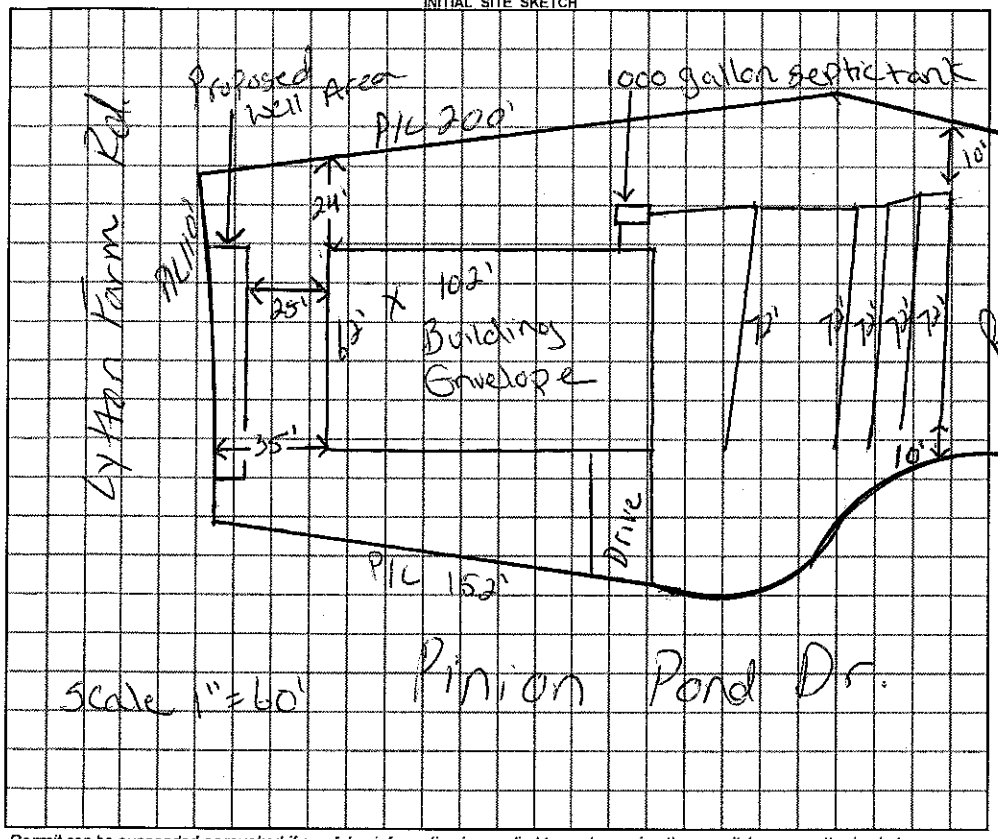

AS BUILT SKETCH

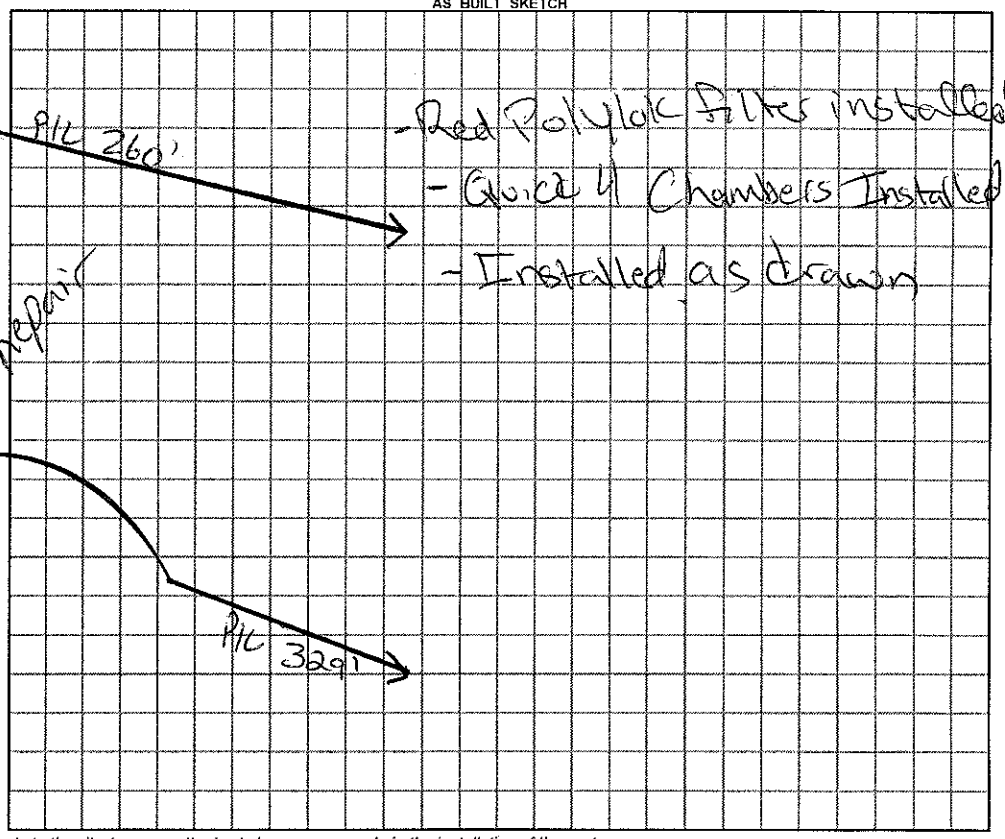

Permit can be suspended or revoked if any false information is supplied toward securing the permit / any unauthorized changes are made to the site / any unauthorized changes are made in the installation of the system.

☐ ***IMPROVEMENT PERMIT*** with plat valid without expiration. ☑ ***IMPROVEMENT PERMIT*** with plat ~~valid without expiration~~ site plan valid 60 mo. ☑ ***AUTHORIZATION TO CONSTRUCT*** valid for period equal to IMPROVEMENT PERMIT--not to exceed 60 mo.

Owner / Applicant Signature: [signature] Date 11/14/12 Installed by: Shannon Henderson Ground Breakers

IMPROVEMENT PERMIT by: Justin Henderson REHS Date 11-8-12 OPERATION PERMIT by: Justin Henderson REHS Date 12-13-12

AUTHORIZATION TO CONSTRUCT by: Justin Henderson REHS Date 11-8-12 Existing System Inspected by: ____ REHS Date ____

YOU SHOULD CONTACT A LOCATOR SERVICE PRIOR TO ANY EXCAVATION

White Copy – Environmental Health YELLOW COPY (Final) Owner / Applicant PINK COPY (Initial) Owner / Applicant