IREDELL COUNTY HEALTH DEPARTMENT

Statesville Office (704) 878-5305 Mooresville Office (704) 660-3625

NEW # — 212729 PERMIT # 180108

IMPROVEMENT PERMIT / AUTHORIZATION TO CONSTRUCT / OPERATION PERMIT / EXISTING SYSTEM

PIN # 4731325718

APPLICANT: Larry Barger APPLICANT ADDRESS: 103 Shenandoah Loop, Troutman

SITE ADDRESS: 579 Talley Rd. PHONE: 704 682 9773 ALT. PHONE:


SITE DIRECTIONS: From Statesville - South on Hwy 21, take (R) on Talley - Lots beside 563 Talley

SUBDIVISION: n/a SECTION: n/a LOT # n/a LOT AREA: 1.72 DESIGN FLOW: 360 L.T.A.R.: .3

Septic Tank	1000	(gal)	STB	1012	Date	12-16-15	☒ New System	☐ Repair	☐ Expansion	System Type: I II (III) IV V VI	☒ Residence	No. Bedrooms	3	Water Supply	
Pump Tank	n/a	(gal)	PT	n/a	Date	n/a	System Description:	25% Reduction Gravity			☐ Business	No. Persons		☒ Private	
Pump Make	n/a	Model	Infiltrite		Serial #	EF-4	Repair System Description:	25% Reduction Gravity			☐ Other	No. Employees		☐ Public	
# Nitrification Fields	1	# Lines	3		Linear Ft:	300	Maintenance Agreement Required:	☐ YES	☒ NO		☐ Slab	☒ Crawl Space		☐ Community	
Trench Width	36"	Max. Trench Bottom Depth	36"		Gravel Depth	n/a		☒ GRAVITY	☐ PRESSURE		☐ Basement w/plumbing		☐ Basement w/o plumbing		

Comments / Conditions: Lots must be combined and recorded before CA shall be issued.

INITIAL SITE SKETCH

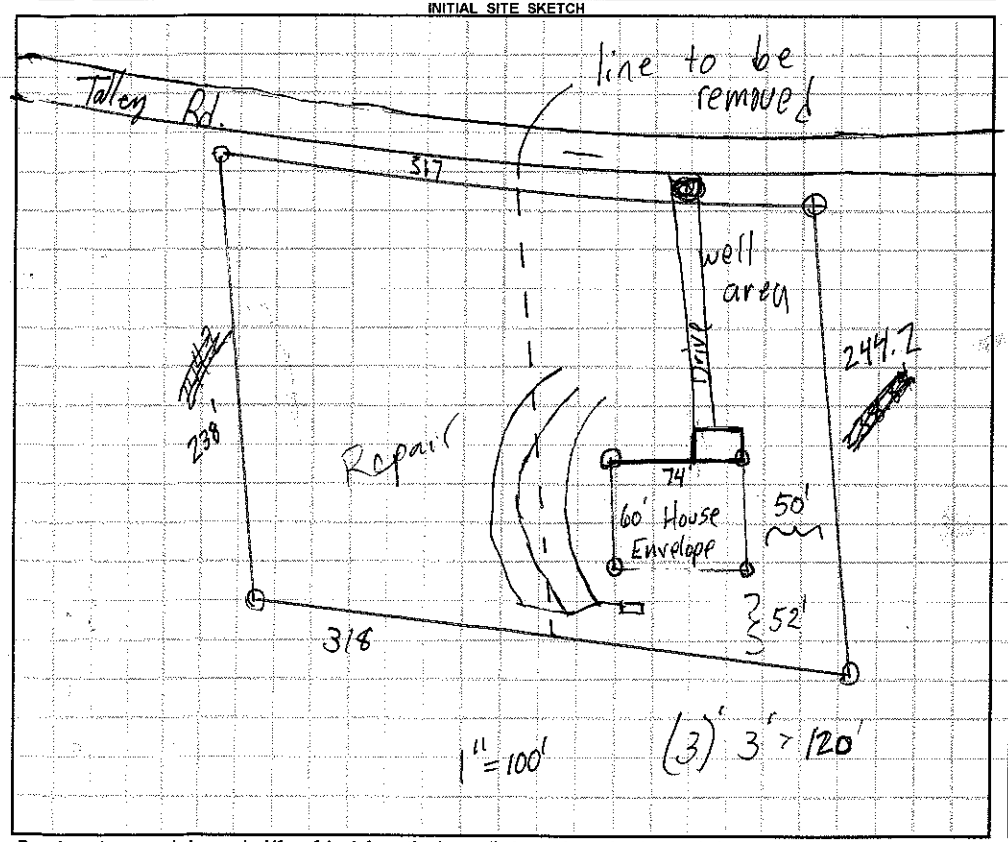

AS BUILT SKETCH

Installed Quad as drawn

Permit can be suspended or revoked if any false information is supplied toward securing the permit / any unauthorized changes are made to the site / any unauthorized changes are made in the installation of the system. **CONTACT A LOCATOR SERVICE PRIOR TO ANY EXCAVATION**

☐ **IMPROVEMENT PERMIT** *with plat valid without expiration.* ☒ **IMPROVEMENT PERMIT** *with site plan valid for 60 mos.* ☑ **AUTHORIZATION TO CONSTRUCT** *valid for period equal to IMPROVEMENT PERMIT--not to exceed 60 mo.*

Owner / Applicant Signature: Larry Barger Date: 10/10/13

IMPROVEMENT PERMIT by: James Date: 10-7-13

AUTHORIZATION TO CONSTRUCT by: Justin Henderson Date: 4-14-15

Installed by: Tommy Frye

OPERATION PERMIT by: Robert Brown Date: 03/11/16

Existing System Inspected by: Date:

Health Dept. Copy - WHITE Applicant (Final Approval) - YELLOW Applicant (Conditional Approval) - PINK