IREDELL COUNTY HEALTH DEPARTMENT

STATESVILLE 704-878-5305 MOORESVILLE 704-664-5281

IMPROVEMENT PERMIT / CERTIFICATE OF COMPLETION / OPERATION PERMIT / EXISTING SYSTEM INSPECTION

PROPERTY DESCRIPTION NO. 07-2-0197 DATE 7-25-97 TAX MAP NO. 4731 39 9878 Watershed: ☐ Yes ☐ No

OWNER OR CONTRACTOR Donald S. Clodfelter PHONE: Business Home 528-0996

ADDRESS 175 E. Mando Rd

LOCATION Off mtn Rd Turn East mando 1/2 mi Rt

SUBDIVISION BLOCK / SECTION LOT LOT AREA 1.213 acres SITE CLASS. PS DESIGN FLOW 360 L.T.A.R. .33

Septic Tank: 1000 Gallons; STB 825 Date 5-19-97

Pump Tank: Gallons; PT Date

Pump Make: Model Serial No.

Nitrification Field: No Fields 1 Square Feet 1080 Linear Feet 360

No Lines 3 Trench Width 36" Max Trench Bottom Depth 36" Gravel Depth 12"

☑ New System ☐ Repair System Type: I, II, III, IV, V, VI

System Description: Conv. Gravity

Repair System Description Gravity Chambers

Maintenance Agreement Required: ☐ Yes ☐ No

☐ House/Mod. Home No. Bedrooms 3

☑ Mobile Home No. Bathrooms 2

☐ Business No. Employees

☐ Other


☐ Slab ☐ Crawl Space ☐ Basement w/plumbing ☐ Basement wo/plumbing

Water Supply: ☑ Individual ☐ Community ☐ Public


Comments:

Comments:

INITIAL SITE SKETCH

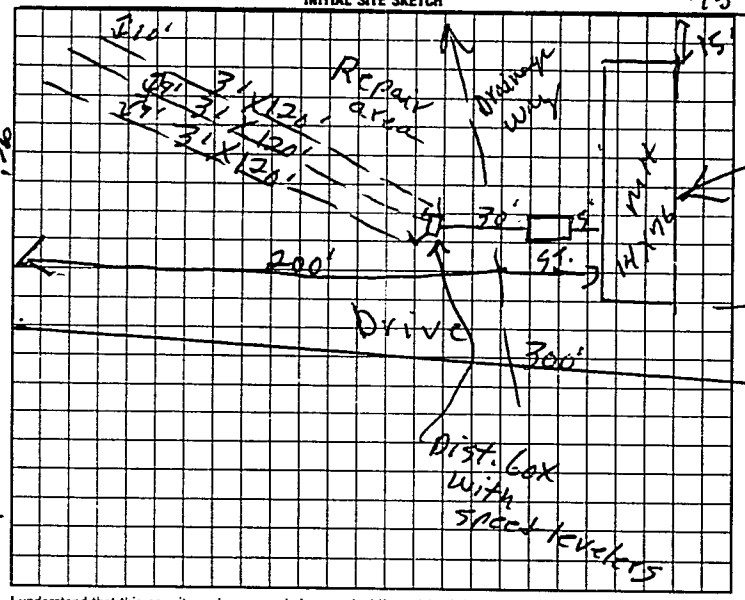

AS BUILT SKETCH

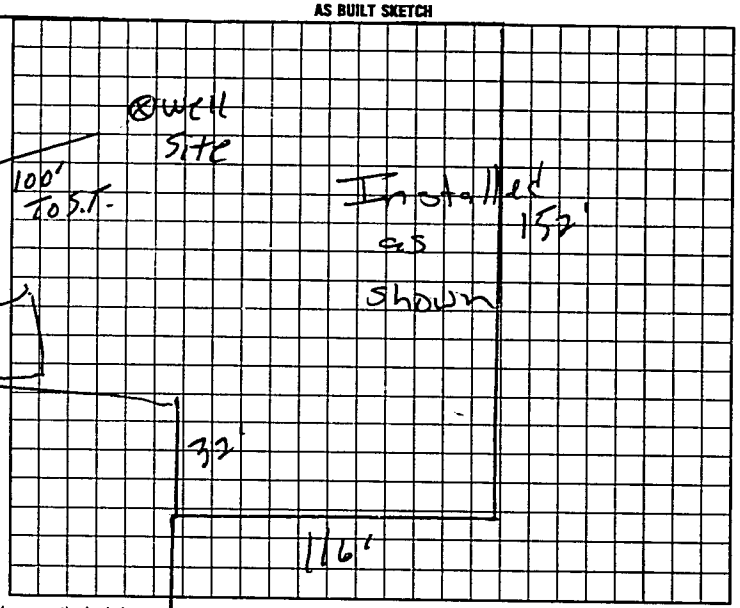

I understand that this permit can be suspended or revoked if any false information is supplied toward securing the permit/any unauthorized changes are made to the site/any unauthorized changes are made in the installation of the system. Improvement Permit is valid for 60 months from date of issuance.

Signed:

Improvement Permit by: P. C. Moore date 7-25-97

Existing System Inspection by: P. C. Moore date 7-25-97

Installed by: Rowan Septic

Certificate of Completion by: date

Operation Permit by: Mary C. Ott RS date 8-14-97

HEALTH DEPT COPY: WHITE INSPECTION COPY (FINAL): GREEN OWNER COPY (FINAL): YELLOW INSPECTION COPY (INITIAL): PINK OWNER COPY (INITIAL): GOLD

Authorization to Court Expires 60 mos from issue

to court.

6 1 1000