IREDELL COUNTY HEALTH DEPARTMENT - *ENVIRONMENTAL HEALTH* ☒ STATESVILLE OFFICE 704-878-5305 ☐ MOORESVILLE OFFICE 704-664-5281

IMPROVEMENT PERMIT / AUTHORIZATION TO CONSTRUCT / OPERATION PERMIT / EXISTING SYSTEM INSPECTION

PERMIT # 165787 PIN # 473139987 8 DATE 3-16-11

OWNER Donald Clodfelter APPLICANT: Freedom Homes Trustman PHONE: Home/Cell # Business # 704-746-4778

SITE ADDRESS 188 E. Monbo OWNER / APPLICANT ADDRESS 1124 Charlotte Hwy, Trustman, NC


SITE DIRECTIONS 115 S to Trustman, (R) on Old Mountain Road, (L) on E. Monbo Road - prop on left

SUBDIVISION n/a BLOCK / SECTION n/a LOT # n/a LOT AREA 1.213 Acres DESIGN FLOW 360 L.T.A.R. ex


Septic Tank (ex) 1000	Gallons: STB ex	Date ex	☐ New System ☐ Repair ☐ Expansion System Type I (II) III IV V VI		☒ Residence	No. Bedrooms 3	Water Supply
Pump Tank	Gallons: P T	Date	System Description: Existing Conv. Gravity		☐ Business	No. Persons	☒ Private
Pump Make	Model	Serial #	Repair System Description:		☐ Other	No. Employees	☐ Public
No. Nitrification Fields: 1	No. Lines 3 (ex)	Linear Feet 360 (ex)	Maintenance Agreement Required ☐ YES ☒ NO		☐ Slab	☒ Crawl Space	☐ Community
Trench Width 36"	Max. Trench Bottom Depth 36"	Gravel Depth 12"	☒ GRAVITY ☐ PRESSURE		☐ Basement w/plumbing	☐ Basement w/o plumbing	

Comments / Conditions

INITIAL SITE SKETCH

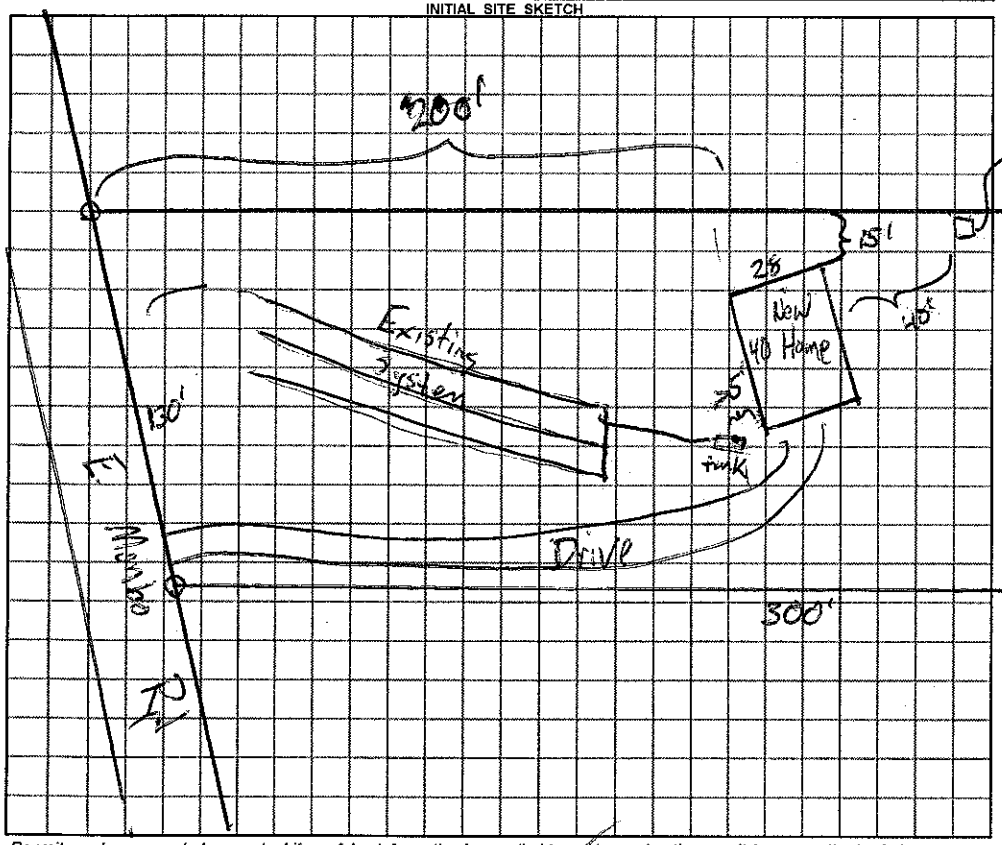

AS BUILT SKETCH

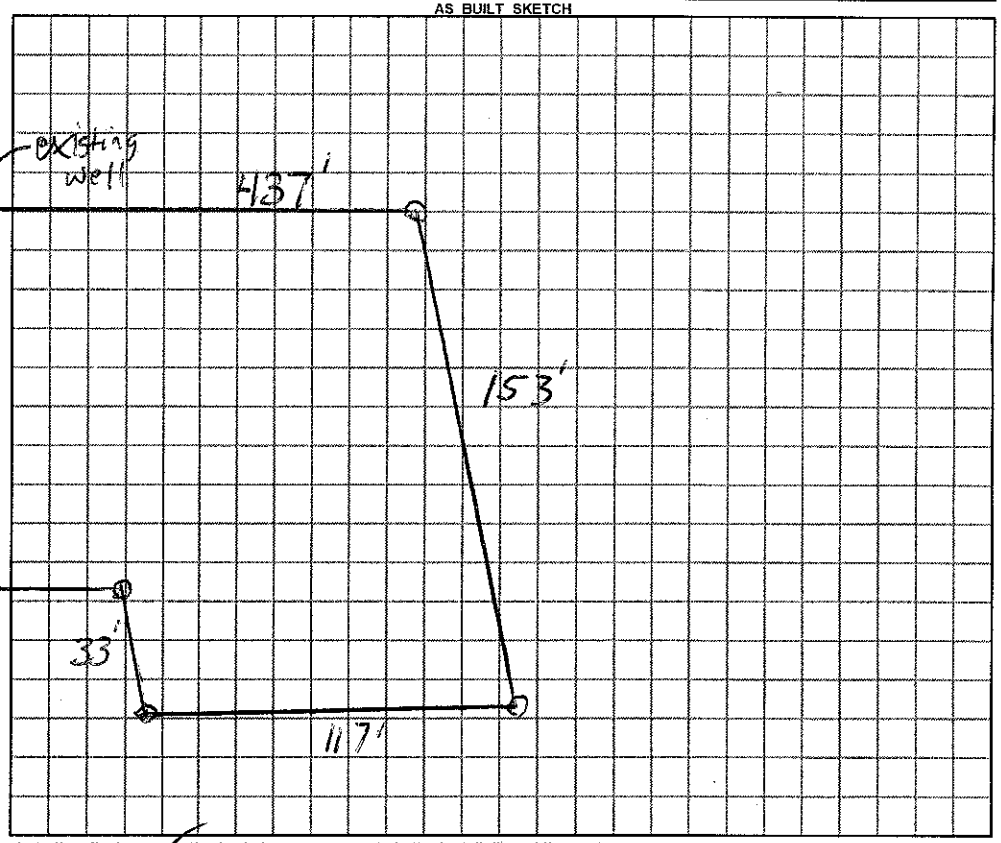

Permit can be suspended or revoked if any false information is supplied toward securing the permit / any unauthorized changes are made to the site / any unauthorized changes are made in the installation of the system.

☐ ***IMPROVEMENT PERMIT*** *with plat valid without expiration.* ☒ ***IMPROVEMENT PERMIT*** *with plat valid without expiration. site plan valid 60 mo.* ☒ ***AUTHORIZATION TO CONSTRUCT*** valid for period equal to IMPROVEMENT PERMIT--not to exceed 60 mo.

Owner / Applicant Signature: [signature] Date 3-18-11 Installed by:

IMPROVEMENT PERMIT by: [signature] REHS Date 3-16

AUTHORIZATION TO CONSTRUCT by: REHS Date

OPERATION PERMIT by: REHS Date

Existing System Inspected by: [signature] REHS Date 3-16-11

YOU SHOULD CONTACT A LOCATOR SERVICE PRIOR TO ANY EXCAVATION

White Copy – Environmental Health YELLOW COPY (Final) Owner / Applicant PINK COPY (Initial) Owner / Applicant