ICHD–ENVIRONMENTAL HEALTH DIVISION

Statesville Office (704) 878-5305

PERMIT # 245354

SEPTIC IMPROVEMENT PERMIT / AUTHORIZATION TO CONSTRUCT / OPERATION PERMIT / EXISTING SYSTEM

PIN # 4731412490 ✓

APPLICANT/OWNER: Paulette Moore

APPLICANT ADDRESS: 169 Lytton Farm Rd Troutman, NC 28166

SITE ADDRESS: 169 Lytton Farm Rd Troutman, NC 28166

PHONE: 704-231-7958

ALT. PHONE —

SITE DIRECTIONS: NC 115 N to L on Talley St, L on Lytton Farm Rd, Lot will be on L

SAP CONTROLLED: ☐ YES ☒ NO

SUBDIVISION: —

SECTION: — LOT # — LOT AREA: 14 acres


DESIGN FLOW: 360 GPD L.T.A.R.: —

Septic Tank	1000	(gal)	STB INFILTRATOR	Date INFILTRATOR	☐ New System	☒ Repair	☐ Expansion	System Type: I	II	III	IV	V	VI
Pump Tank	—	(gal)	PT —	Date —	System Description:	Existing							
Pump Make	—	Model —		Serial # —	Repair System Description:	Existing							
# Nitrification Fields	1	# Lines	Existing	Linear Ft: Existing	Maintenance Agreement Required:	☐ YES	☒ NO						
Trench Width	Existing	Trench Bottom Depth(Low side)		Existing	Gravel Depth —	☒ GRAVITY	☐ PRESSURE						

☒ Residence	No. Bedrooms	3	Water Supply
☐ Business	No. Persons	6	☒ Private
☐ Other	No. Employees		☐ Public
☐ Slab	☒ Crawl Space		☐ Community
☐ Basement w/plumbing	☐ Basement w/o plumbing		

Comments / Conditions: Pump, crush and Fill old tank and follow all NC Tank Abandonment rules

INITIAL SITE SKETCH

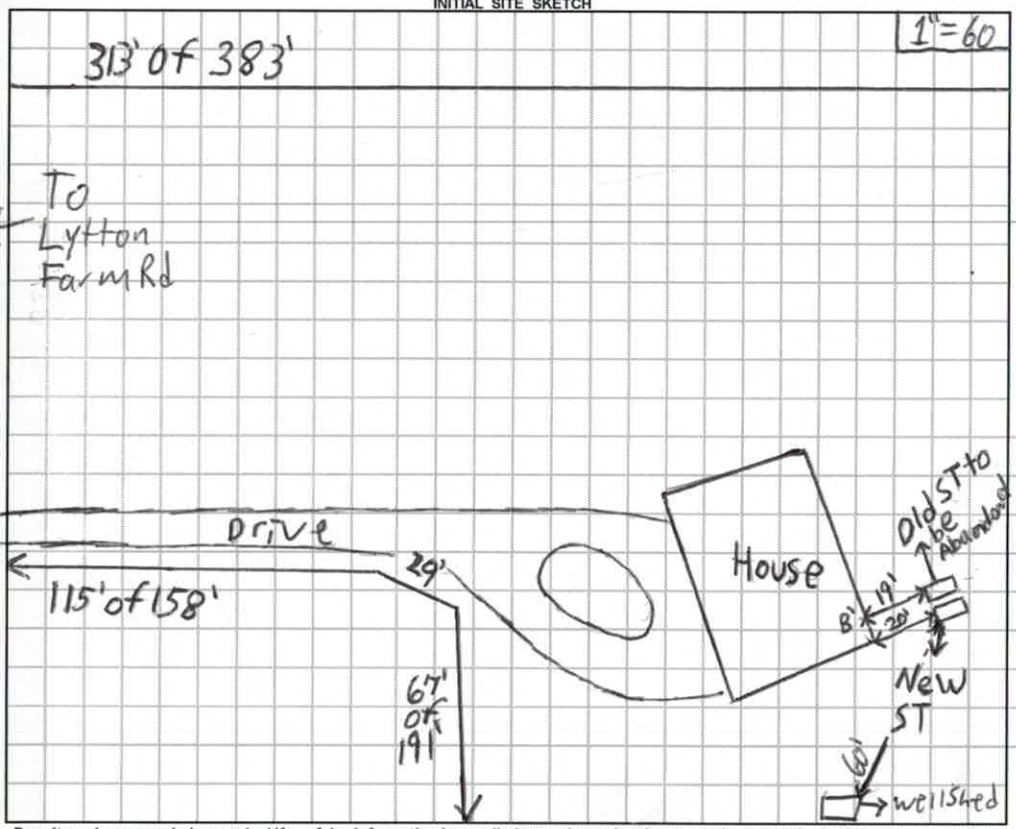

AS BUILT SKETCH

INSTALLED AS PERMITTED

Permit can be suspended or revoked if any false information is supplied toward securing the permit / any unauthorized changes are made to the site / any unauthorized changes are made in the installation of the system. **CONTACT A LOCATOR SERVICE PRIOR TO ANY EXCAVATION**

☐ **IMPROVEMENT PERMIT** *with plat valid without expiration.* ☒ **IMPROVEMENT PERMIT** *with site plan valid for 60 mos.* ☐ **AUTHORIZATION TO CONSTRUCT** *valid for period equal to IMPROVEMENT PERMIT--not to exceed 60 mo.*

Owner / Applicant Signature: Paulette Moore Date: 6-12-19 Installed by: T. W. AMMONS

IMPROVEMENT PERMIT by: Patrick J Byrd III Date: 06/11/19 OPERATION PERMIT by: Burgess L White Date: 6-27-19

AUTHORIZATION TO CONSTRUCT by: Patrick J Byrd III Date: 06/11/19 Existing System Inspected by: Date:

FOR SEPTIC FINAL INSPECTION: CALL 704-664-3703 between 8am-9am the day the inspection is needed. Be sure to speak with an inpsector to confirm your inspection time.

#295354
6.4.19
NO charge.

IREDELL COUNTY DEPARTMENT of ENVIRONMENTAL HEALTH

APPLICATION FORM

Application For: ( ) New Well Permit ( ) Well Repair Permit ( ) Well Abandonment
( ) Septic Improvement Permit ( ) Authorization to Construct ( ) Existing System Inspection (✓) Septic System Repair

THE ABOVE PERMIT DOCUMENTS WILL BECOME INVALID IF INFORMATION PROVIDED ON THIS APPLICATION IS FALSIFIED OR CHANGED, OR IF THE SITE IS ALTERED. THE IMPROVEMENT PERMIT IS VALID FOR EITHER 60 MONTHS OR WITHOUT EXPIRATION DEPENDING UPON DOCUMENTATION SUBMITTED. APPLICATION WITH SITE PLAN 60 MONTHS, APPLICATION WITH COMPLETE, SCALED PLAT WITHOUT EXPIRATION. SEE 15A NCAC 18A .1937(f) FOR DETAILS.

Page 2: *Site Plan Worksheet* formMUST accompany this application

The following optional attachments may also be submitted: ( ) Survey Plat, scaled no more than 1 inch = 60 feet
Place an(X) beside whichever is submitted if applicable ( ) Custom Site Plan, scaled no more than 1 inch = 60 feet

Applicant Information:(PRINT CLEARLY)

Applicant Name: Paulette Moore **Address:** 169 Lytton Farm Rd **Zip:** 28166
Applicant Email: Paulette.moore1951@Yahoo.com **Phone:** 704 231 7958 **Alt. Phone:**
Owner Name: Gwendolyn Paulette Moore **Address:** 169 Lytton Farm Rd **Zip:** 28166
Owner Email: Paulette.moore1951@Yahoo.com **Phone:** 704 231 7958 **Alt. Phone:**

Property Information:

Street Address: 169 Lytton Farm Rd. Troutman NC. 28166
Subdivision Name: N/A **Section/Phase:** **Lot Number:**
Driving Directions: North on 21 Right on Talley Rd Left on Lytton Farm Rd

Site Development Information: *(check or complete ALL that apply*

CHECK FOUNDATION TYPE

( ) New Single Family Residence — Maximum Number of Bedrooms: ( ) Crawl Space Foundation ( ) New Multi-Family Residence
Maximum Number of Occupants: ( ) Concrete Slab Foundation
( ) Accessory Building ( ) Swimming Pool ( ) Basement with Plumbing
( ) Bedroom(s) Addition ( ) Other Addition/Structure: ( ) Basement without Plumbing
(✓) Repair to failing septic system 1500 Tank 6 Drain lines Describe Problem: Old Tank
Non-Residential Site Development: Type of Business:
Square Footage of Building: Max. Number of Employees: 9 Max. Number of Seats/Beds/Other:

Water Supply: ( ) Replacement Well – Reason:
( ) Multi-connection Well Number of Houses: Number of Persons:

( ) New Well (✓) Existing Well ( ) Community Well ( ) City Water ( ) Other Public Water

Desired Septic System Type: *(you may rank in order of preference)* Year existing system installed:
(✓) No Preference ( ) Alternative ( ) Conventional ( ) Innovative ( ) Modified Conventional ( ) Other:

Please answer the following ( ) Yes (✓) No Does the site contain any jurisdictional wetlands?
to the best of your ability: ( ) Yes (✓) No Is any non-domestic sewage (i.e. industrial) to be generated?
( ) Yes (✓) No Is the site subject to approval by any other public agency?

I have read this application and certify that the information provided herein is true, complete, and correct. Authorized county and state officials are granted right of entry to conduct necessary inspections to determine compliance with applicable laws and rules. I understand that I am solely responsible for the proper identification and labeling of all property lines and corners and making the site accessible so that a complete site evaluation can be performed.

Signature: Thomas A Moore Jr B Paulette Moore 5-31-19
Property owner or owner's legal representative signature (SIGNATURE REQUIRED) DATE


IREDELL COUNTY DEPARTMENT of ENVIRONMENTAL HEALTH

SITE PLAN WORKSHEET

SEE THE "SAMPLE SITE PLAN" BELOW. *INCOMPLETE SITE PLANS WILL BE RETURNED TO YOU FORCOMPLETION AND MAY RESULT IN A DELAY IN THE ISSUANCE OF YOUR SEPTIC SYSTEM OR WELL PERMIT!!!*

Place an (X) beside each item as you complete the site plan:

- (✓) Property Line measurements are clearly identified
- (✓) All proposed structures are indicated
- (✓) Front and side setbacks from property line
- (✓) Preferred driveway location
- (✓) Preferred well location
- (✓) Preferred septic system location
- ( ) North arrow, or other sufficient indicator of direction

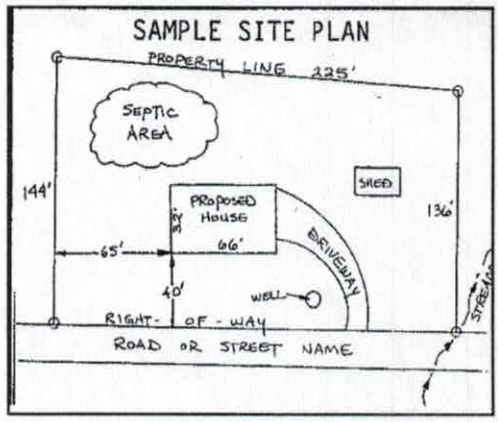


Circle N/A on the following if appropriate:

Location of septic systems and wells within 100' of your property	N/A
Location of easements and rights of ways on your property	N/A
Location of any designated wetlands on the property	N/A

USE THIS SPACE TO DRAW YOUR SITE PLAN

Show: proposed house or business footprint, wells, water lines, patios, pools and decks, and any other item that will occupy space on the site

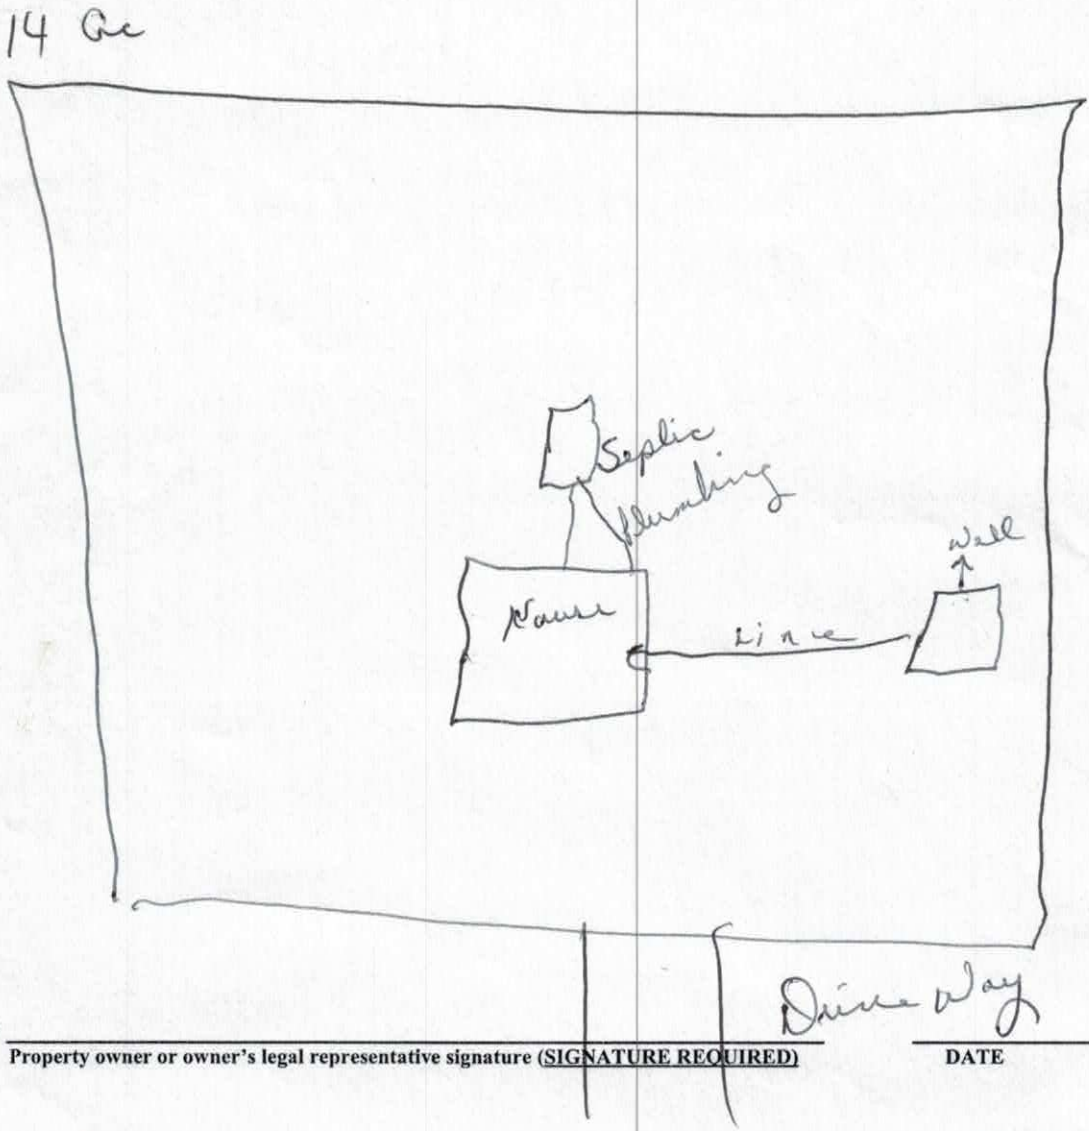

Signature: _____ _____

Property owner or owner's legal representative signature (SIGNATURE REQUIRED) **DATE**

ENVIRONMENTAL HEALTH

DOCUMENTATION TO AUTHORIZE AN OWNER'S LEGAL REPRESENTATIVE

(Check and sign only ONE of the options below)

1. * APPLICANT AND OWNER ARE THE SAME. * (*Sign here***)** Gwendolyn Paulette Moore

Applications for permits require the "signature of the owner or owner's legal representative" (15A NCAC 18A .1937). If the owner does not sign the application himself or herself, they can submit any one of the following documents to designate their legal representative: *Power of Attorney; Real Estate Contract; Estate executor; Bankruptcy trustee; Court ordered guardianship* In the absence of the above documentation, the property owner may provide the local health department with documentation that designates a legal representative. A property owner may:
Complete this form to document his or her legal representative, or provide his or her own form that contains the information in this form. If there are multiple property owners, then all property owners must sign the form that designates a legal representative.

By signing a form that designates a legal representative for purposes of 15A NCAC 18A .1937, the property owner authorizes that representative to act on their behalf in matters pertaining to the application and permitting process, including signing or receiving any application, document or permit. The owner retains full responsibility to meet all permit conditions specified by the local health department.

Gwendolyn Paulette Moore

2. I, Thomas R Moore Jr, am the legal owner(s) of the property located at 169 Lytton Farm Rd, identified as

PIN (Parcel Identification Number) 4731-41-2490, located in Iredell County, North Carolina.

I do hereby authorize (**print legal representative/company name**) _____,

_____, to act as an agent on my behalf in applying for/signing/obtaining any of the documents described below.

- Application for Improvement Permit (IP) / Authorization to Construct (AC)
- Improvement Permit (IP) / Authorization to Construct (AC)
- Application for soil-site evaluation (new/repair)
- Application/permit for private drinking water well/well abandonment
- Application for Compliance Inspection

I agree to abide by all decisions and/or conditions between the legal representative acting on my behalf and the Iredell County Department of Public Health, Environmental Health Division.

Gwendolyn Paulette Moore
Thomas Atkins Moore Jr.

Signature of Owner(s)

6-3-19
Date

Mooresville - Environmental Health
ronda.hart@co.iredell.nc.us
Fax: 704-662-3239
610 E. Center Avenue, Mooresville, NC 28115

Statesville - Environmental Health
adrienne.shea@co.iredell.nc.us
Fax: 704-871-3483
349 N. Center Street, Statesville, NC 28677