(CI) See attached garage addition 4/0 in 2/2010.

IREDELL COUNTY HEALTH DEPARTMENT

STATESVILLE 704-878-5305 MOORESVILLE 704-664-5281

IMPROVEMENT PERMIT / AUTHORIZATION TO CONSTRUCT / OPERATION PERMIT / EXISTING SYSTEM INSPECTION

PERMIT# 149023 PIN# 4731-43-1310 DATE 31 MARCH 08

OWNER OR APPLICANT A. Todd Rankin PHONE: Business 704-902-2143 Home

ADDRESS 612 Signal Hill Dr. Ext. Statesville, N.C.

LOCATION Hwy 21 to Truitman. TR Talley Rd. on Rt. Across from Lyton Rd.

SUBDIVISION BLOCK / SECTION LOT LOT AREA SITE CLASS. PS DESIGN FLOW 360gpd L.T.A.R. 0.3g/d/ft²

Septic Tank: 1000 Gallons: STB 1015 Date 10-3-07

Pump Tank: Gallons: PT Date

Pump Make: Model Serial No.

Nitrification Field: No Fields 1 Square Feet ≈1200 Linear Feet 300'

No Lines 3 Trench Width 36" Max Trench Bottom Depth 36"

☑ New System ☐ Repair ☐ Expansion System Type: I II III IV V VI

System Description: 25% Reduction

Repair System Description: 25% Reduction

Maintenance Agreement Required: ☐ Yes ☑ No

☑ House/Mod. Home No. Bedrooms 3

☐ Mobile Home No. Persons

☐ Business No. Employees

☐ Other

Water Supply: ☑ Individual ☐ Public ☐ Community

Gravel Depth ☑ Gravity ☐ Pressure ☐ Slab ☑ Crawl Space ☐ Basement w/plumbing ☐ Basement wo/plumbing

Comments:/Conditions:

Follow contours / Honor all setbacks

Comments:/Conditions:

T.H. tile to be installed
ST has marker / Fuel cap to end cap

INITIAL SITE SKETCH

Please see Attached Layout plan.

AS BUILT SKETCH

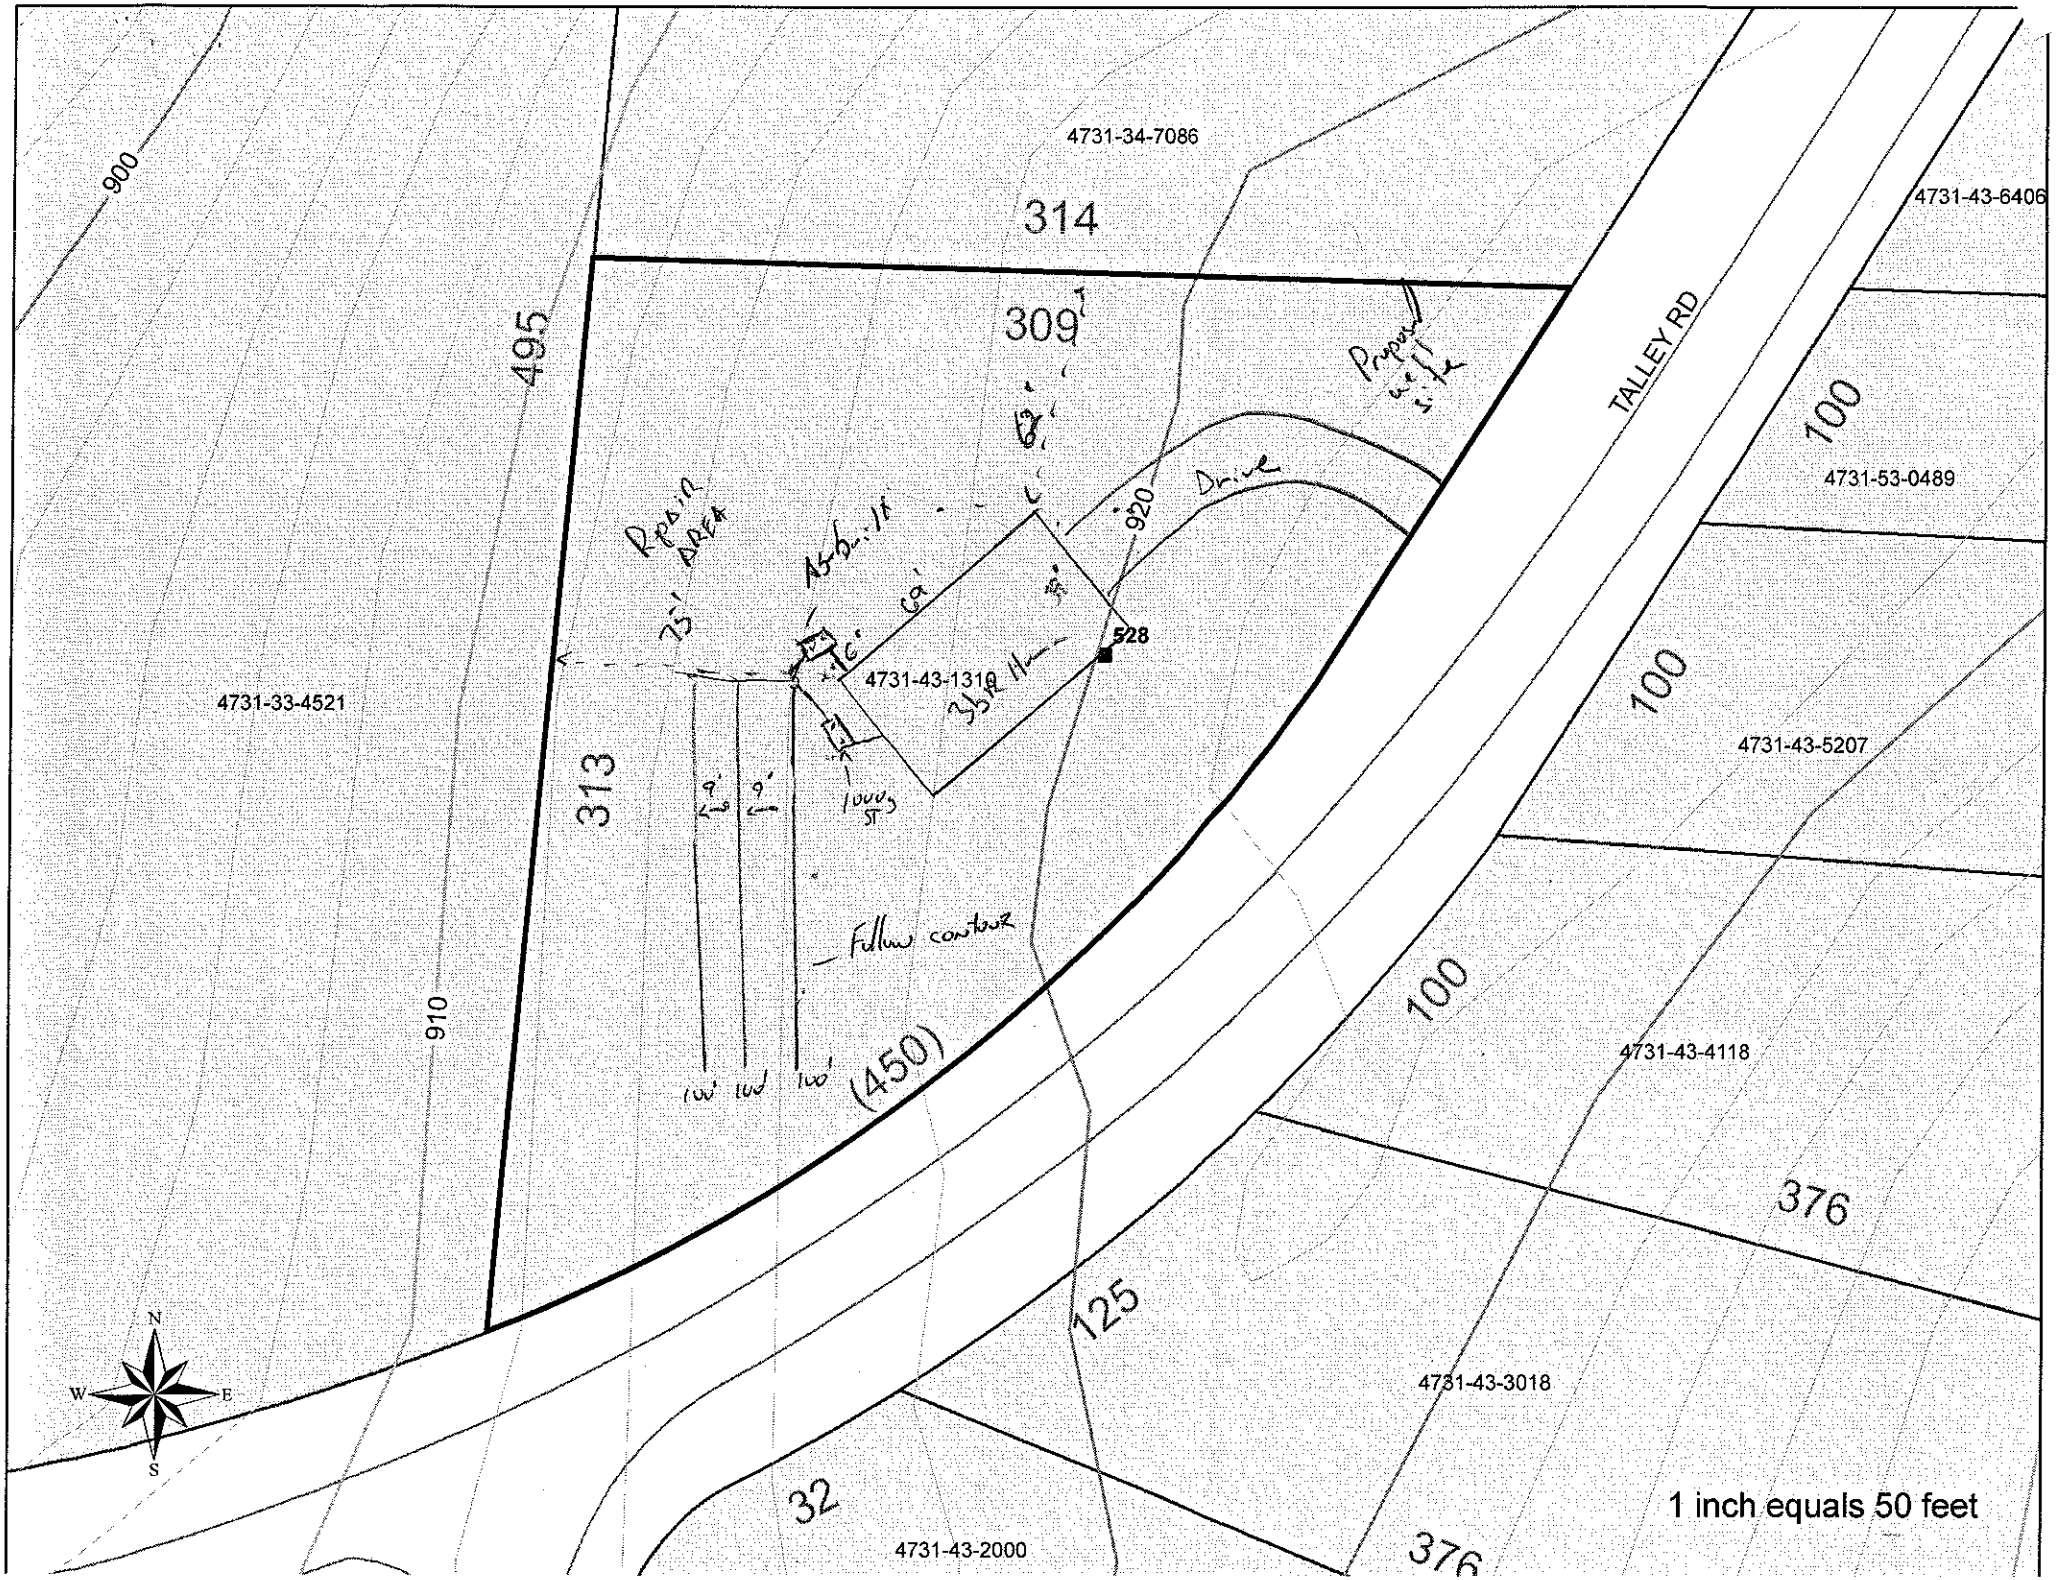
Permit can be suspended or revoked if any false information is supplied toward securing the permit/any unauthorized changes are made to the site/any unauthorized changes are made in the installation of the system. Improvement Permit with plat valid without expiration ☐ Improvement Permit with site plan valid for sixty months ☑ Authorization to Construct is valid for a period equal to that of Improvement Permit – not to exceed sixty months.

Signed: date 3-31-08 Installed by: Longview Septic

Improvement Permit by: , R.S. date 31 March 08 Operation Permit by: , R.S. date 3/31/08

Authorization to Construct by: , R.S. date 31 March 08 Existing System Inspection by: date

HEALTH DEPT. COPY: WHITE OWNER COPY (FINAL): YELLOW OWNER COPY (INITIAL): PINK


4731-34-7086
314
309
4731-43-6406
TALLEY RD
Proposed well site
920 Drive
100
4731-53-0489
Repair AREA
75'
69'
35'
528
4731-43-1310
4731-33-4521
313
100
4731-43-5207
9'
9'
Follow contour
910
(450)
100
4731-43-4118
100 100 100
376
125
4731-43-3018
N
W
E
S
32
4731-43-2000
376
1 inch equals 50 feet