(CI)

IREDELL COUNTY HEALTH DEPARTMENT

STATESVILLE 704-878-5305 MOORESVILLE 704-664-5281

IMPROVEMENT PERMIT / AUTHORIZATION TO CONSTRUCT / OPERATION PERMIT / EXISTING SYSTEM INSPECTION

PERMIT# 149023 PIN# 4731-43-1310 DATE 31 MARCH 08

OWNER OR APPLICANT A. Todd Bonkin PHONE: Business 704-902-2143 Home

ADDRESS 612 Signal Hill Dr. Ext. Statesville, NC

LOCATION Hwy 21 to Amity. TR Into Hill on Rt. Across from Lyton Rd.

SUBDIVISION BLOCK / SECTION LOT LOT AREA SITE CLASS. PS DESIGN FLOW 360gpd L.T.A.R. 0.3gpd/ft²

Septic Tank: 1000 Gallons: STB 1075 Date 10-2-07
Pump Tank: Gallons: PT Date
Pump Make: Model Serial No.
Nitrification Field: No Fields 1 Square Feet ≈1200 Linear Feet 300'
No Lines 3 Trench Width 36" Max Trench Bottom Depth 30"

☑ New System ☐ Repair ☐ Expansion System Type: I II (III) IV V VI
System Description: 25% Reduction
Repair System Description: 25% Reduction
Maintenance Agreement Required: ☐ Yes ☑ No
Gravel Depth ☑ Gravity ☐ Pressure

☑ House/Mod. Home No. Bedrooms 3
☐ Mobile Home No. Persons
☐ Business No. Employees
☐ Other

Water Supply: ☑ Individual ☐ Public ☐ Community

☐ Slab ☑ Crawl Space ☐ Basement w/plumbing ☐ Basement wo/plumbing

Comments:/Conditions:
Follow Contours / Honor all setbacks

Comments:/Conditions:
Tuff-Tite fittings install
5T Has Marker / Fwd cap to end cap

INITIAL SITE SKETCH

Please see Attached Layout plan.

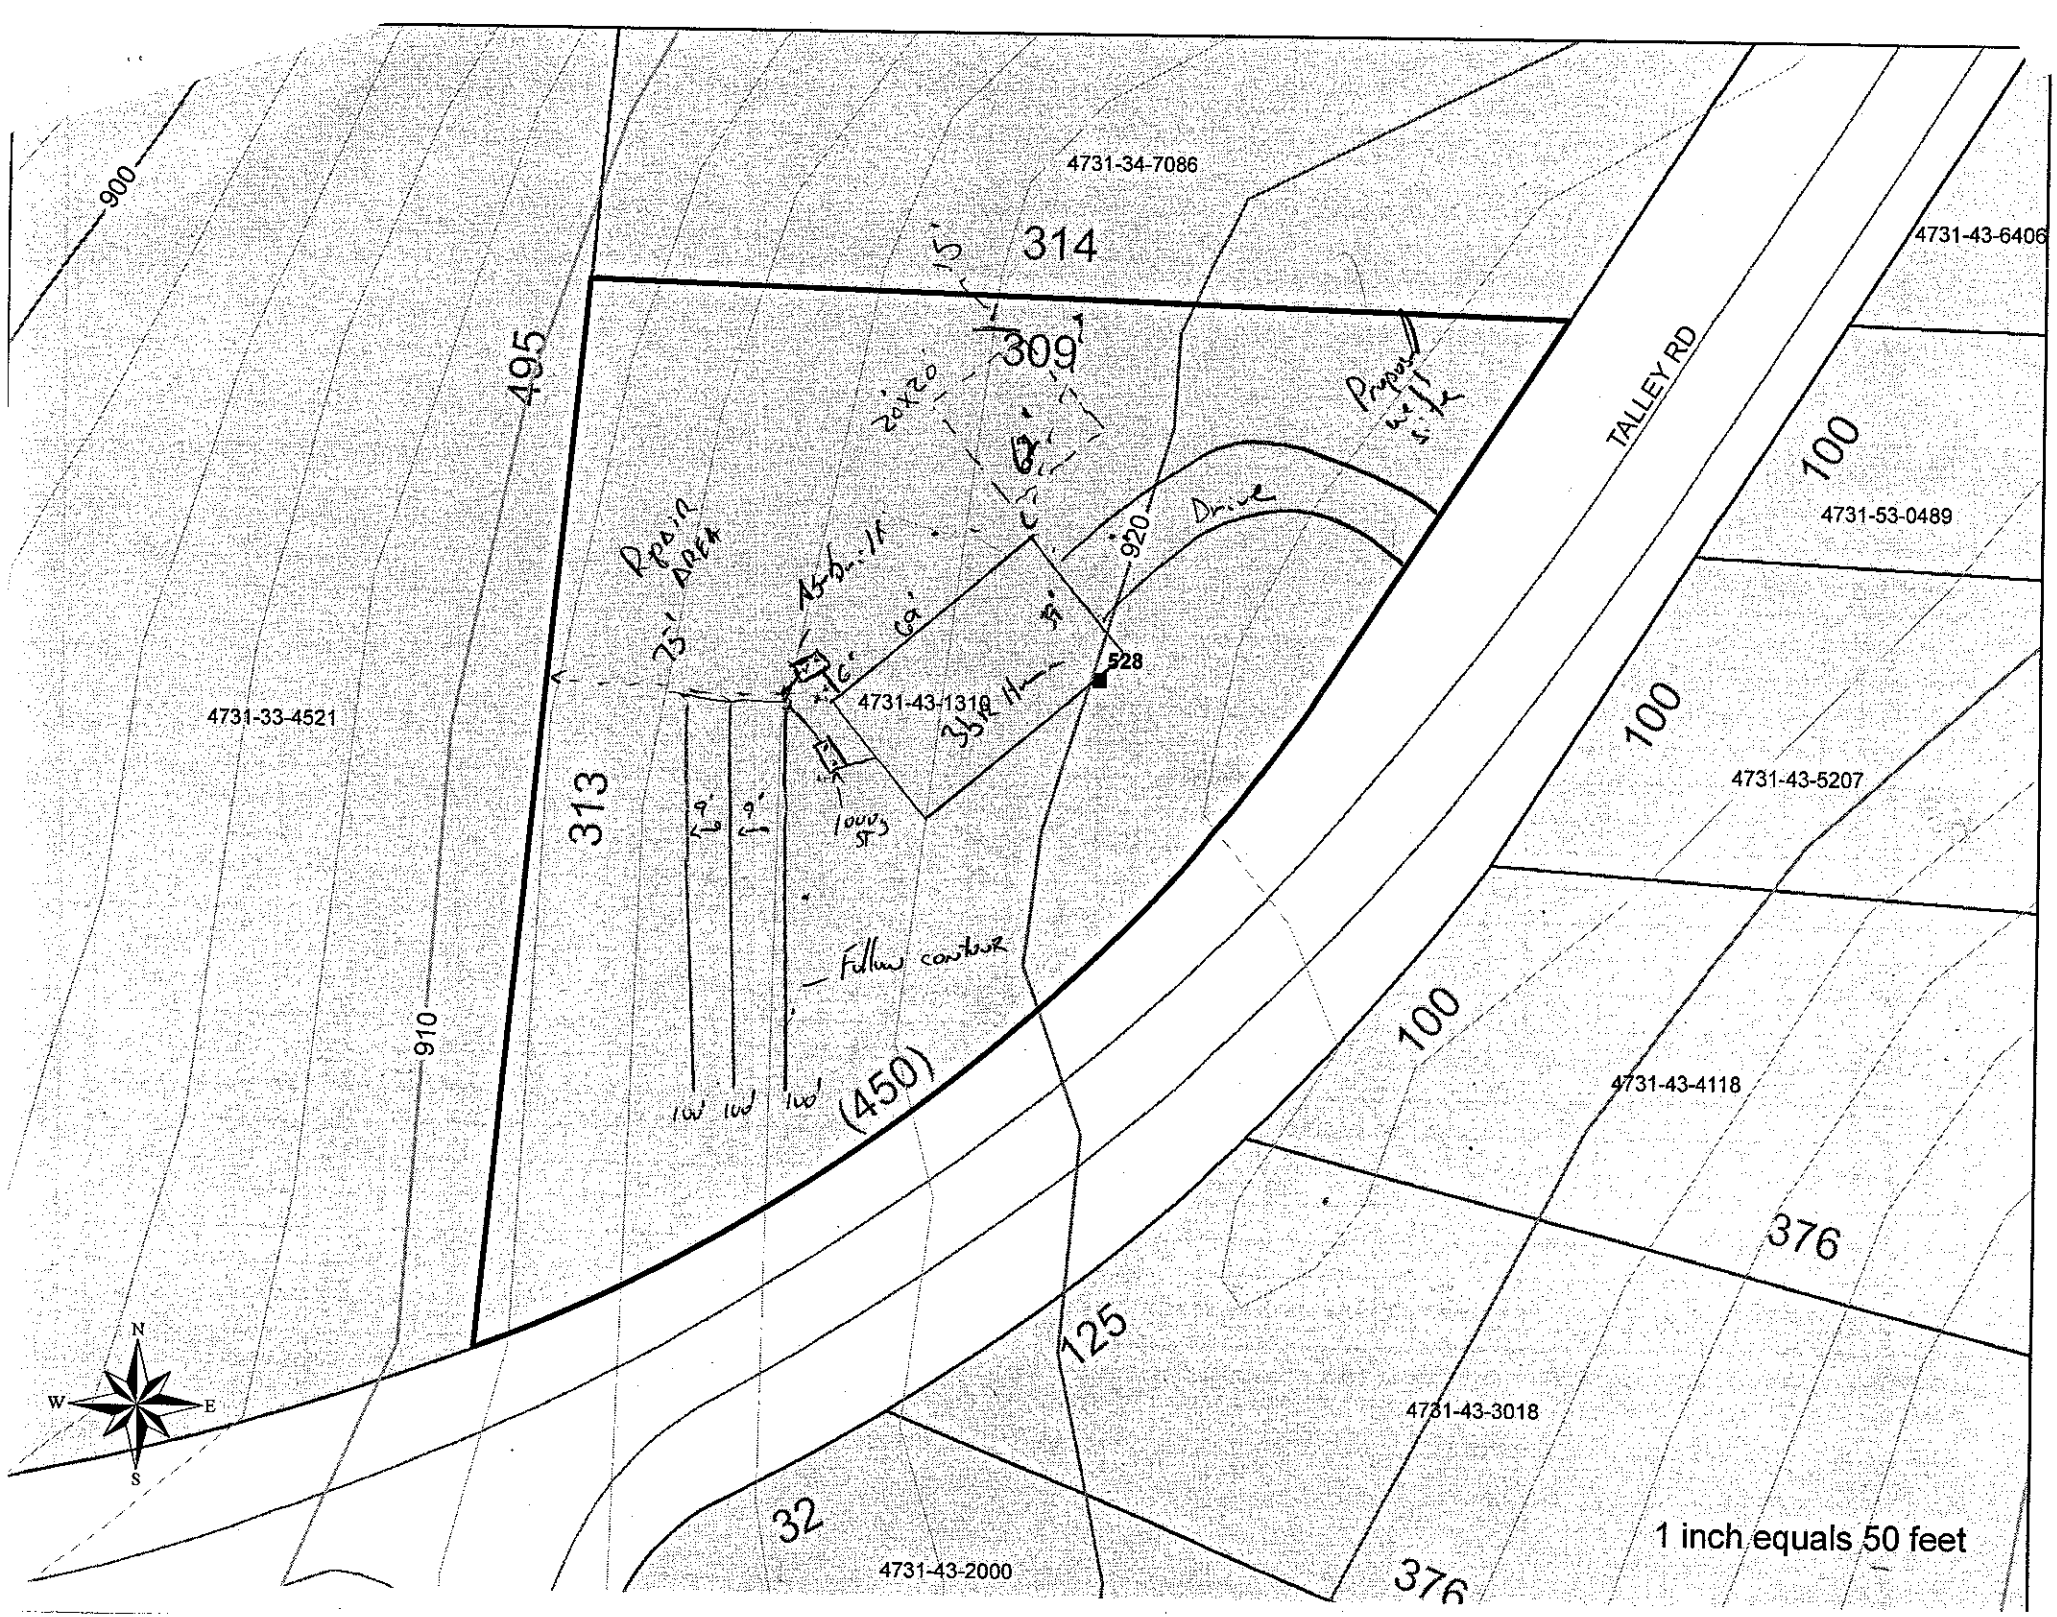
AS BUILT SKETCH

The proposed 20'X20' detached garage addition does not appear to impact the existing septic system.
**NOTE: R.S.
Date: 2-19-2010
ICHD-Environmental Health Division

Permit can be suspended or revoked if any false information is supplied toward securing the permit/any unauthorized changes are made to the site/any unauthorized changes are made in the installation of the system. Improvement Permit with plat valid without expiration ☐ Improvement Permit with site plan valid for sixty months ☑ Authorization to Construct is valid for a period equal to that of Improvement Permit – not to exceed sixty months.

Signed: date 3-31-08
Improvement Permit by: R.S. date 31 March 08
Authorization to Construct by: R.S. date 31 March 08
Installed by: date
Operation Permit by: R.S. date 31 March 08
Existing System Inspection by: date

HEALTH DEPT. COPY: WHITE OWNER COPY (FINAL): YELLOW OWNER COPY (INITIAL): PINK


4731-34-7086
4731-43-6406
4731-53-0489
4731-43-5207
4731-43-4118
4731-43-3018
4731-43-2000
4731-43-1310
4731-33-4521
TALLEY RD
314
309'
313
495
900
910
100
100
100
376
125
32
376
(450)
20x20
Drive
920
528
Follow contour
1 inch equals 50 feet
N
S
E
W