Statesville Office

IMPROVEMENT PERMIT / AUTHORIZATION TO CONSTRUCT / OPERATION PERMIT / EXISTING SYSTEM

PERMIT # 22/913 10

PIN # 4731-43-6406

APPLICANT: Janie M. Dixon

APPLICANT ADDRESS: 2070 Vance Street. Newton, NC

SITE ADDRESS: 515 Talley Road Troutman, NC 28166

PHONE: ALT. PHONE:

SITE DIRECTIONS: Rt 21 N from Downtown Troutman → L on Talley Rd → 1 mile ahead on left (house)


SUBDIVISION: — SECTION: — LOT # — LOT AREA: 1.5/ acres DESIGN FLOW: 240 GPD L.T.A.R.: 0.275

Septic Tank	1000 (gal)	STB	160	Date	2-2-17	☒ New System ☐ Repair ☐ Expansion	System Type: I II (III) IV V VI	☒ Residence	No. Bedrooms 3
Pump Tank	— (gal)	PT	—	Date	—	System Description:	25% Reduction	☐ Business	No. Persons 4
Pump Make	—	Model	—	Serial #	—	Repair System Description:	50% Reduction	☐ Other	No. Employees
# Nitrification Fields	1	# Lines	3	Linear Ft:	220	Maintenance Agreement Required:	☐ YES ☒ NO	☒ Slab	☐ Crawl Space
Trench Width	36"	Max. Trench Bottom Depth	33" [low side]	Gravel Depth	—		☒ GRAVITY ☐ PRESSURE	☐ Basement w/plumbing	☐ Basement w/o plumbing


Water Supply: ☒ Private ☐ Public ☐ Community

Comments / Conditions: Follow all N.C. septic rules. Recommend pumping septic tank every 3-5 years. There are to be NO bedrooms within the barn. Construction of any bedrooms violates this permit. Though 230 l.f. of drainfield laid out only 220 need be installed. 2-2-17.

INITIAL SITE SKETCH

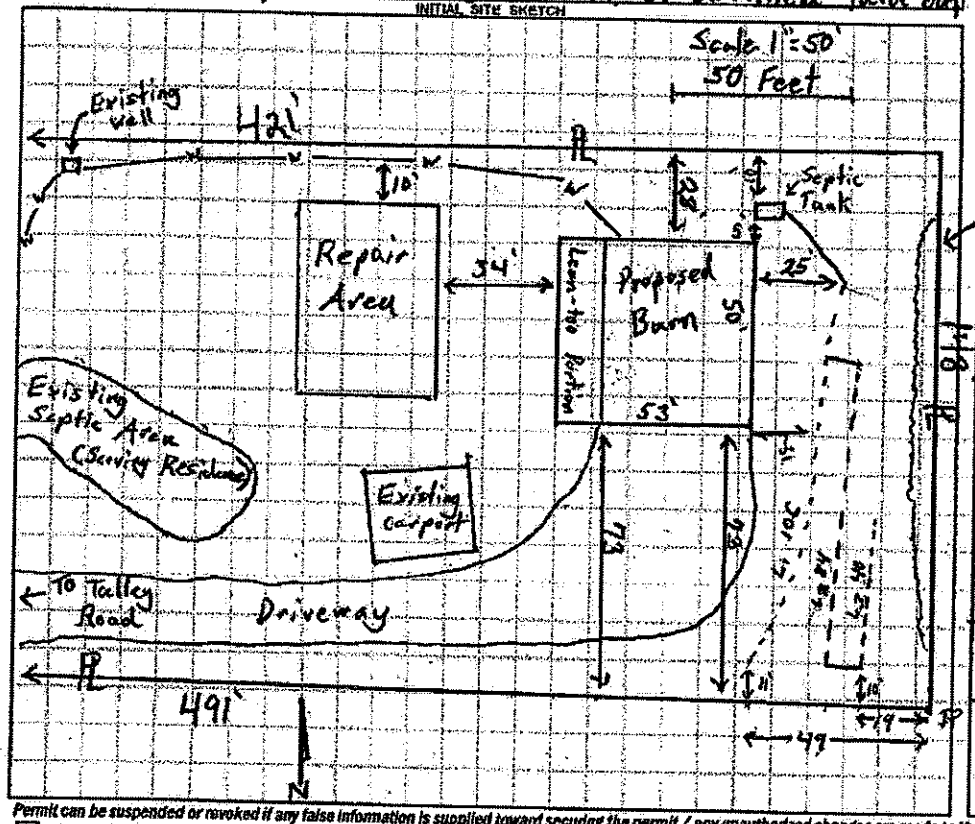

AS BUILT SKETCH

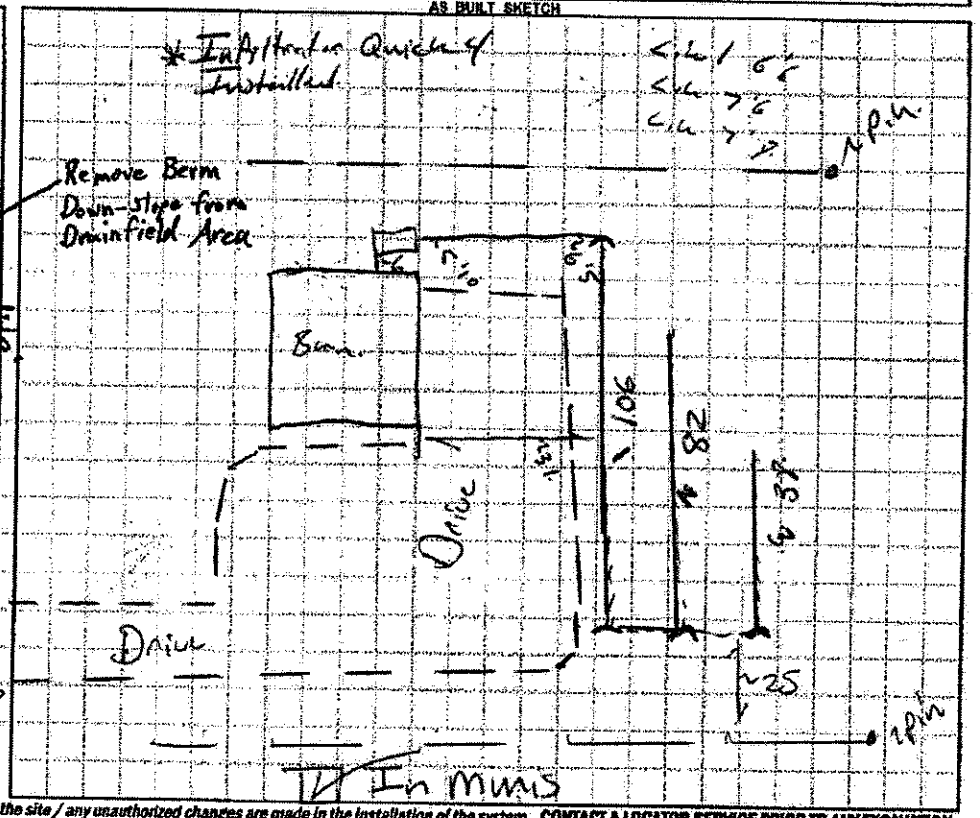

Permit can be suspended or revoked if any false information is supplied toward securing the permit / any unauthorized changes are made to the site / any unauthorized changes are made in the installation of the system. CONTACT A LOCATOR SERVICE PRIOR TO ANY EXCAVATION

☐ IMPROVEMENT PERMIT with plat valid without expiration. ☒ IMPROVEMENT PERMIT with site plan valid for 60 mos. ☒ AUTHORIZATION TO CONSTRUCT valid for period equal to IMPROVEMENT PERMIT--not to exceed 60 mo.

Owner / Applicant Signature: Date: 11/1/16

IMPROVEMENT PERMIT by: Date: 10/31/16

AUTHORIZATION TO CONSTRUCT by: Date: 10/31/16

Installed by: Chuck Sims RJC Construction 499.

OPERATION PERMIT by: B. Botkins Date: 3/21/17

Existing System Inspected by: Date:

Health Dept. Copy - WHITE Applicant (Final Approval) - YELLOW Applicant (Conditional Approval) - PINK