074682

IREDELL COUNTY HEALTH DEPARTMENT

STATESVILLE 704-878-5305 MOORESVILLE 704-664-5281

IMPROVEMENT PERMIT / AUTHORIZATION TO CONSTRUCT / OPERATION PERMIT / EXISTING SYSTEM INSPECTION

PERMIT# 05-2-0498 PIN# 4731 49 1981

OWNER OR CONTRACTOR William Galloway PHONE: Business DATE 6-15-98

ADDRESS 176 East moore RD Troutman N.C Home 528 4467

LOCATION 21S TR 0MB TL East moore 1/4 mi rt

SUBDIVISION BLOCK / SECTION LOT LOT AREA 1/2 acre SITE CLASS. PS DESIGN FLOW 360 L.T.A.R. 1.35

Septic Tank: 3X Gallons; STB Date

Pump Tank: Gallons; PT Date

Pump Make: Model Serial No.

Nitrification Field: No Fields 1 Square Feet 345 Linear Feet 115

No Lines 1 Trench Width 36" Max Trench Bottom Depth 36" Gravel Depth 12"

☑ New System ☐ Repair System Type: I, II, III, IV, V, VI

System Description:

Repair System Description: Conv. Gravity

Maintenance Agreement Required: ☐ Yes ☑ No

☐ House/Mod. Home No. Bedrooms 3

☐ Mobile Home No. Bathrooms 2

☐ Business No. Employees

☐ Other


☐ Slab ☐ Crawl Space ☐ Basement w/plumbing ☐ Basement wo/plumbing

Water Supply: ☑ Individual ☐ Public ☐ Community

Comments:/Conditions:

Comments:/Conditions: Adding bedroom to Existing 2 BR HSE

INITIAL SITE SKETCH

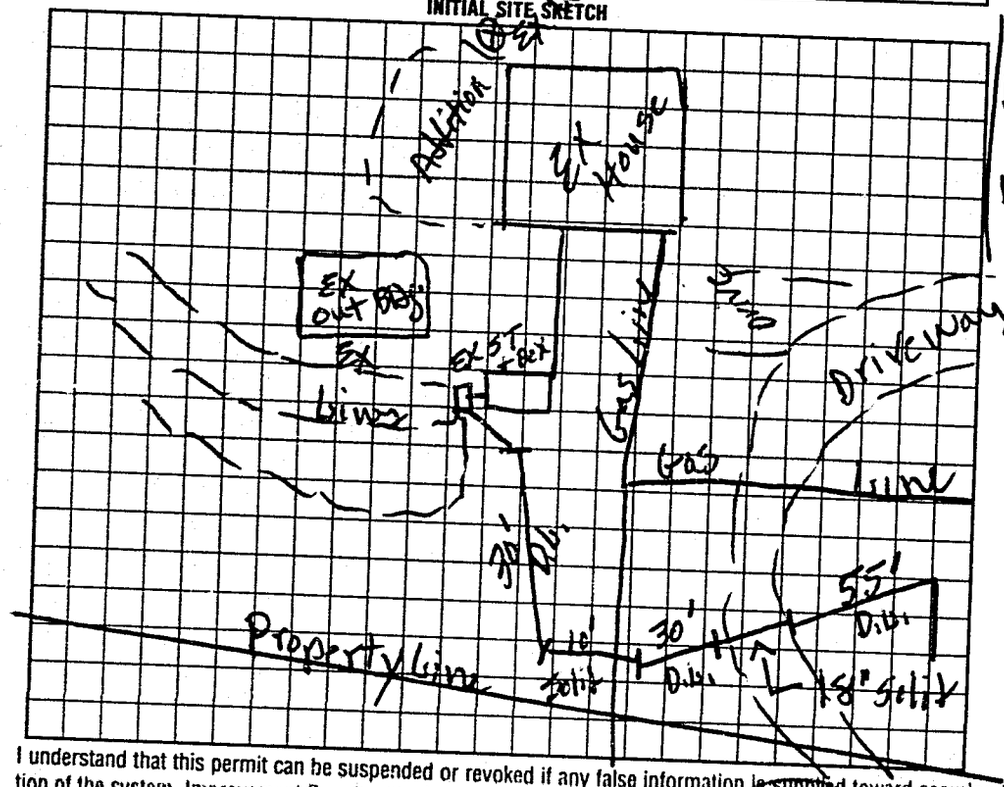

AS BUILT SKETCH

Same as initial sketch

I understand that this permit can be suspended or revoked if any false information is supplied toward securing the permit/any unauthorized changes are made to the site/any unauthorized changes are made in the installation of the system. Improvement Permit with plat valid without expiration. Improvement Permit with site plan valid for sixty months. Authorization to Construct is valid for a period equal to that of Improvement Permit – not to exceed sixty months.

Signed: X William Aaron Galloway date 15 Jun 98

Improvement Permit by: P.C. moore date 6-15-98

Authorization to Construct by: P.C. moore date 6-15-98

Installed by: Lonnie Hutler

Operation Permit by: P.C. moore date 11-24-98

Existing System Inspection by: date

HEALTH DEPT. COPY: WHITE INSPECTION COPY (FINAL): GREEN OWNER COPY (FINAL): YELLOW INSPECTION COPY (INITIAL): PINK OWNER COPY (INITIAL): GOLD