2.30

IREDELL COUNTY HEALTH DEPARTMENT

STATESVILLE 704-878-5305 MOORESVILLE 704-664-5281

IMPROVEMENT PERMIT / AUTHORIZATION TO CONSTRUCT / OPERATION PERMIT / EXISTING SYSTEM INSPECTION

Site Address: 159 East Monbo Rd - Stat.

PERMIT # 154812 / # ✓4731-40-6843 496843 DATE 2-11-09

OWNER or APPLICANT RYAN KEITH Whitehead (Abby) PHONE: Business 704-657-9600 Home:

OWNER or APPLICANT ADDRESS PO BOX 465 MT. MOURNE NC 28123

LOCATION / DIRECTIONS 21 SOUTH R ONR (E) EAST MONBO (D) First Trailer on LEFT PAST EYES

SUBDIVISION — BLOCK / SECTION — LOT # — LOT AREA 32367 DESIGN FLOW 360 L.T.A.R. .3

Septic Tank 1000 Gallons: STB Date

Pump Tank Gallons: P T Date

Pump Make Model Serial #

Nitrification Field No Fields 1 No Lines 2 Linear Feet 135'

Trench Width 36" Max. Trench Bottom Depth 36" Gravel Depth 12"

☐ New System ☐ Repair ☒ Expansion System Type I (II) III IV V VI

System Description: GRAVITY ~~CONVENTIONAL~~

Repair System Description: LP 50% Reduction

Maintenance Agreement Required ☐ YES ☒ NO

☒ GRAVITY ☐ PRESSURE

☐ Residence No. Bedrooms 3

☐ Business No. Persons 6

☐ Other No. Employees

☐ Slab ☒ Crawl Space

☐ Basement w/plumbing ☐ Basement w/o plumbing

Water Supply: ☒ Private ☐ Public ☐ Community

Comments / Conditions (1) This permit was redrawn for house movement only. House IS 26' to well + 5' OFF tank and repair area. This includes the deck. (2) EVERY-Thing was staked at time of visit.

INITIAL SITE SKETCH

SEE ATTACHED SYSTEM DESIGN BY LORNE COOK, R.S.

Comments / Conditions

END CAP distribution

AS BUILT SKETCH

Come out of distribution box on existing system/ Spread out to back new line last 12-30-09

Permit can be suspended or revoked if any false information is supplied toward securing the permit / any unauthorized changes are made to the site / any unauthorized changes are made in the installation of the system.

☐ *IMPROVEMENT PERMIT w / plat valid without expiration.* ☒ *IMPROVEMENT PERMIT w / site plan valid for 60 mos.* ☒ *AUTHORIZATION TO CONSTRUCT valid for period equal to IMPROVEMENT PERMIT-not to exceed 60 mo.*

Owner / Applicant Signature: Keith Whitehead Date 2-13-09

Improvement Permit by: [signature] Date 2-11-09

Authorzation to Construct by: [signature] Date 2-11-09

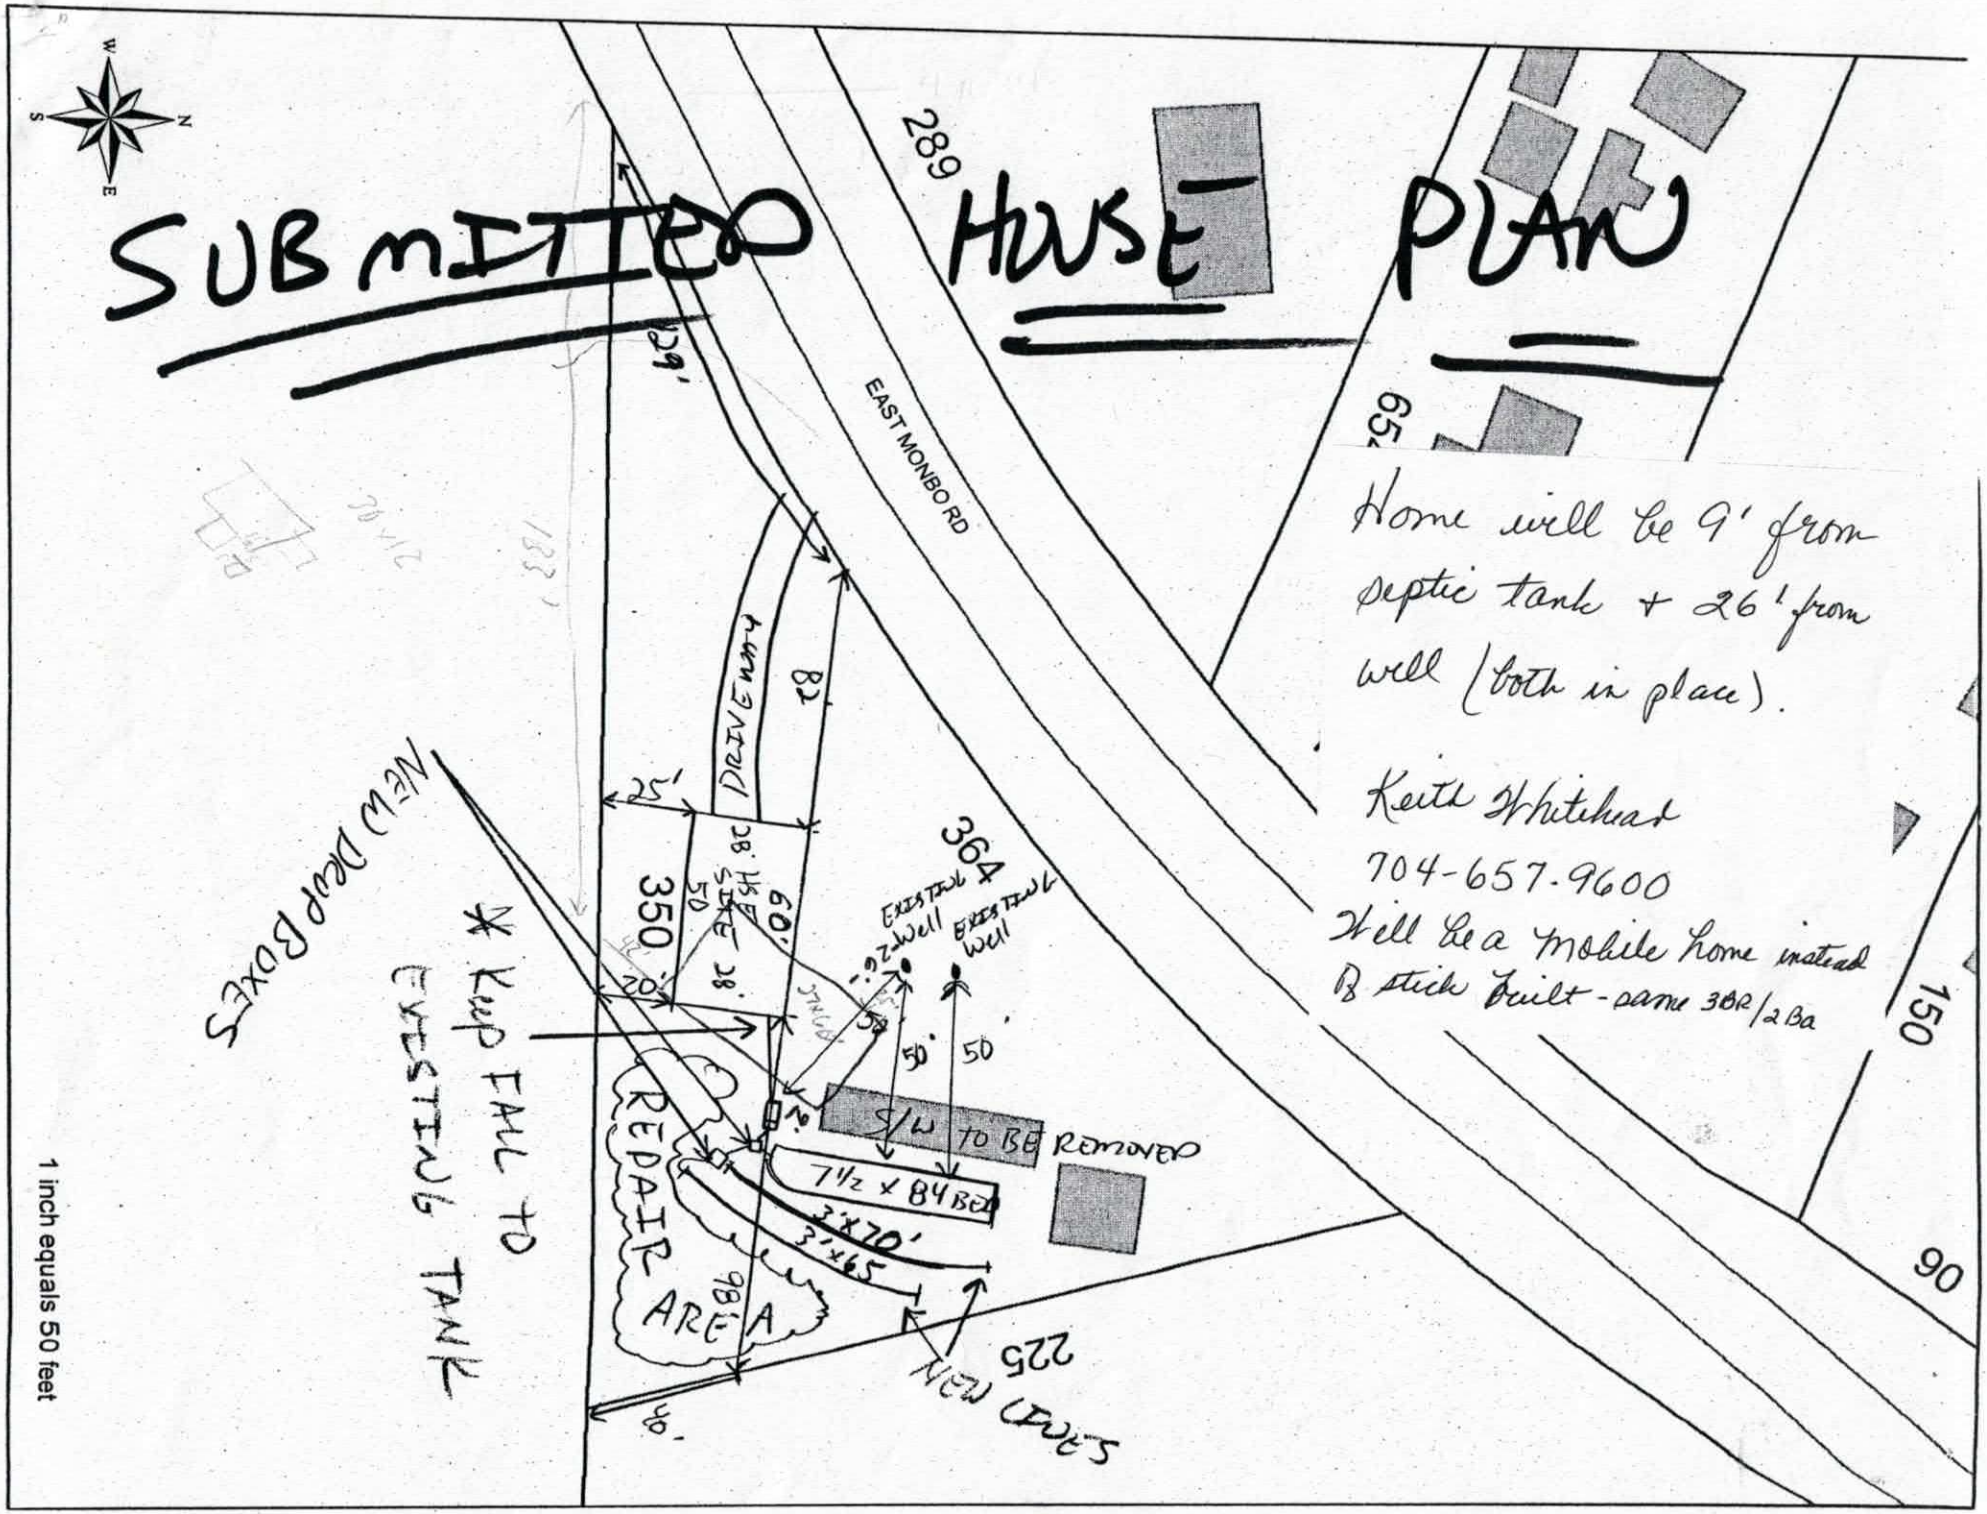
YOU SHOULD CONTACT A LOCATOR SERVICE PRIOR TO ANY EXCAVATION.

Installed by: Wayne Klontz

Operation Permit by: [signature] Date: 12-30-09

Existing System Inspected by: Date:

WHITE COPY Environmental Health YELLOW COPY (Final) Owner / Applicant PINK COPY (Initial) Owner / Applicant


SUBMITTED HOUSE PLAN
289
EAST MONBO RD
DRIVEWAY
82'
25'
350'
364'
EXISTING Well
EXISTING Well
50'
50'
50'
20'
30'
30'
69.09'
* KUP FALL TO EXISTING TANK
S/W TO BE REMOVED
7½ x 84 BED
3'x70'
3'x65'
REPAIR AREA
98'
225
NEW
40'
Home will be 9' from septic tank + 26' from well (both in place).
Keith Whitehead
704-657-9600
Will be a Mobile home instead of stick built - same 3BR/2Ba
150
90
1 inch equals 50 feet