IREDELL COUNTY HEALTH DEPARTMENT

STATESVILLE 704-878-5305 MOORESVILLE 704-664-5281

IMPROVEMENT PERMIT / AUTHORIZATION TO CONSTRUCT / OPERATION PERMIT / EXISTING SYSTEM INSPECTION

PERMIT# (TROUTMAN) 123838 PIN# 4731-54-3726 59 DATE 1/4/05

OWNER OR CONTRACTOR H & H HOMES INC. PHONE: Business (704) 322-1426 Home

ADDRESS 19806 N. COVE RD. #141 CORNELIUS, NC 28031

LOCATION US 21 S TR TALLEY RD 1/2 MILES ON LEFT JUST PAST WEST ST.

SUBDIVISION INGLEWOOD BLOCK / SECTION II LOT 175 LOT AREA 0.68 SITE CLASS. PS DESIGN FLOW 360 L.T.A.R. 0.30 gpd/ft²

Septic Tank: 1000 Gallons; STB ____ Date ____

Pump Tank: ____ Gallons; PT ____ Date ____

Pump Make: ____ Model ____ Serial No. ____

Nitrification Field: No Fields 1 Square Feet 1200 Linear Feet 400

No Lines 4 Trench Width 36" Max Trench Bottom Depth 24" Gravel Depth 12"

☑ New System ☐ Repair System Type: I (II) III, IV, V, VI

System Description: CONVENTIONAL GRAVITY

Repair System Description: LP PANEL 50% REDUCTION

Maintenance Agreement Required: ☐ Yes ☑ No

☑ House/Mod. Home ☐ Mobile Home ☐ Business ☐ Other

No. Bedrooms 3 No. Bathrooms ____ No. Employees ____


Water Supply: ☑ Individual ☐ Public ☐ Community

☐ Slab ☑ Crawl Space ☐ Basement w/plumbing ☐ Basement wo/plumbing


Comments:/Conditions: (1) INSTALL LINES 24" ON CONTOUR (2) MAINTAIN SETBACKS (3) INSTALL SUBSURFACE INTERCEPTOR DRAIN 48" TO DAYLIGHT (4) SMOOTH OUT ROUGH TOPOGRAPHY

Comments:/Conditions: (1) RED POLYLOK FILTER (2) #5 STONE (3) FRENCH DRAIN INSTALLED 48" TO DAYLIGHT (4) SYSTEM INSTALLED AS SHOWN

INITIAL SITE SKETCH

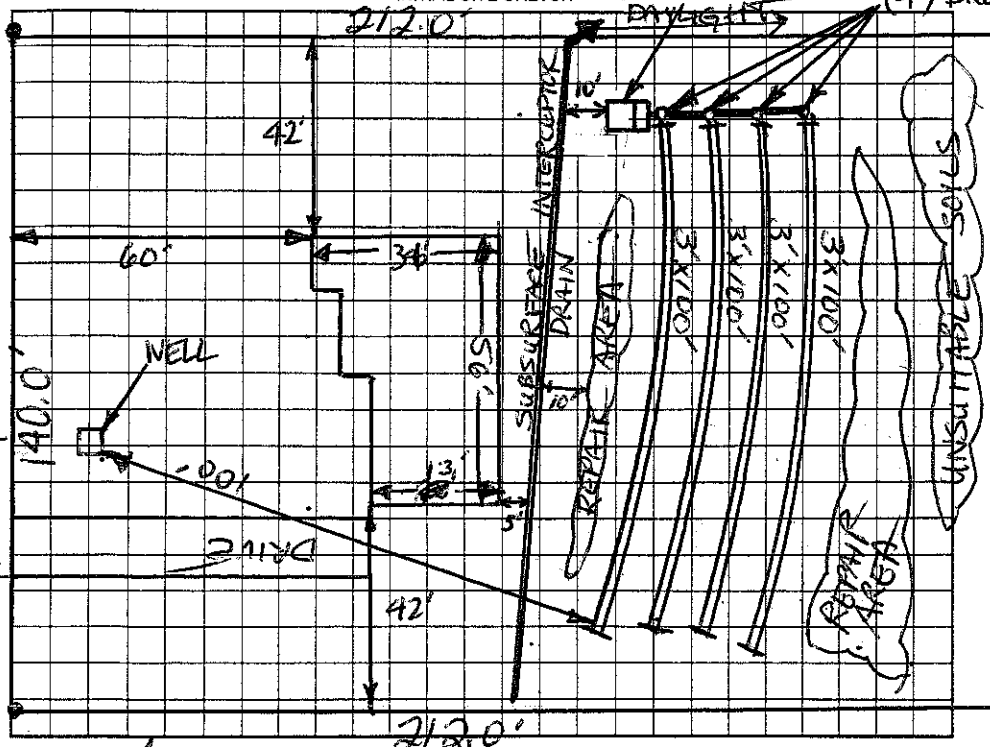

AS BUILT SKETCH

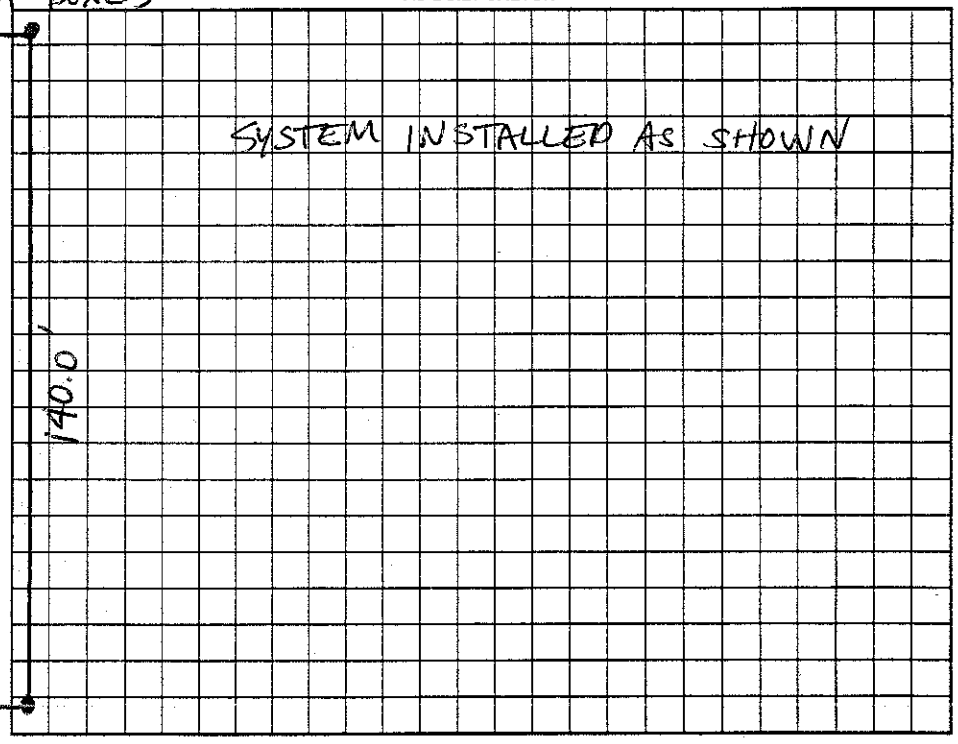

Permit can be suspended or revoked if any false information is supplied toward securing the permit/any unauthorized changes are made to the site/any unauthorized changes are made in the installation of the system. Improvement Permit with plat valid without expiration. Improvement Permit with site plan valid for sixty months. Authorization to Construct is valid for a period equal to that of Improvement Permit – not to exceed sixty months.

Signed: _____ date 1/6/05

Improvement Permit by: Christopher M. Shaw, PS, LSS date 1-4-05

Authorization to Construct by: Christopher M. Shaw, PS, LSS date 1-4-05

Installed by: SPECIALTY SEPTIC (JAMIE O'DANIEL)

Operation Permit by: Christopher M. Shaw, PS, LSS date 1-12-05

Existing System Inspection by: _____ date _____

HEALTH DEPT. COPY: WHITE OWNER COPY (FINAL): YELLOW OWNER COPY (INITIAL): PINK