830 - 4

IREDELL COUNTY HEALTH DEPARTMENT

STATESVILLE 704-878-5305 MOORESVILLE 704-664-5281

IMPROVEMENT PERMIT / AUTHORIZATION TO CONSTRUCT / OPERATION PERMIT / EXISTING SYSTEM INSPECTION

PERMIT# 04-2-0600/92192 PIN# 4731568234 DATE August 9, 2000

OWNER OR CONTRACTOR Roddie E. Saddler @ Olde Towne Mobile Homes PHONE: Business 873-1461 Home

ADDRESS 175 Utah Lane Troutman

LOCATION 115 South TR Talley Street TR 2nd entrance to Ruffin Lp TR Utah Lane A Trailer

SUBDIVISION BLOCK / SECTION LOT LOT AREA .468 Ac SITE CLASS DESIGN FLOW 360 gpd L.T.A.R. .3±

Septic Tank: 1000 Gallons; STB 10 12 Date 9/17/00
Pump Tank: 1000 Gallons; PT 17 Date 9/16/00
Pump Make: Hydromatic Model SHEE 50A1 Serial No. 193380
Nitrification Field: No. Fields 1 Square Feet 450 Linear Feet 150+EX
No Lines 5 EX 3 NEW LINES Trench Width 36" Max Trench Bottom Depth 24"

☐ New System ☐ Repair System Type: I, II, (III), IV, V, VI
System Description: 2BR to EX LINES & 3 NEW INNOV
Repair System Description: LP Lane 1 Block LINES
Maintenance Agreement Required: ☐ Yes ☑ No
Gravel Depth N/A ☐ Slab ☑ Crawl Space ☐ Basement w/plumbing ☐ Basement wo/plumbing


☑ House/Mod. Home No. Bedrooms 3
☐ Mobile Home No. Bathrooms 2
☐ Business No. Employees
☐ Other

Water Supply: ☐ Individual ☑ Public ☐ Community


Comments/Conditions: *Upgrade of Septic System from 2BR to 3BR Capacity. Install pressure manifold in vicinity of EX Distribution Box (Remove old D-Box) Feed EXISTING & NEW Lines off pressure manifold.

Comments/Conditions: Tanks + Lines checked - GM 10/19/00
Pressure checked - GM 10/20/00

INITIAL SITE SKETCH 1" ≈ 40'

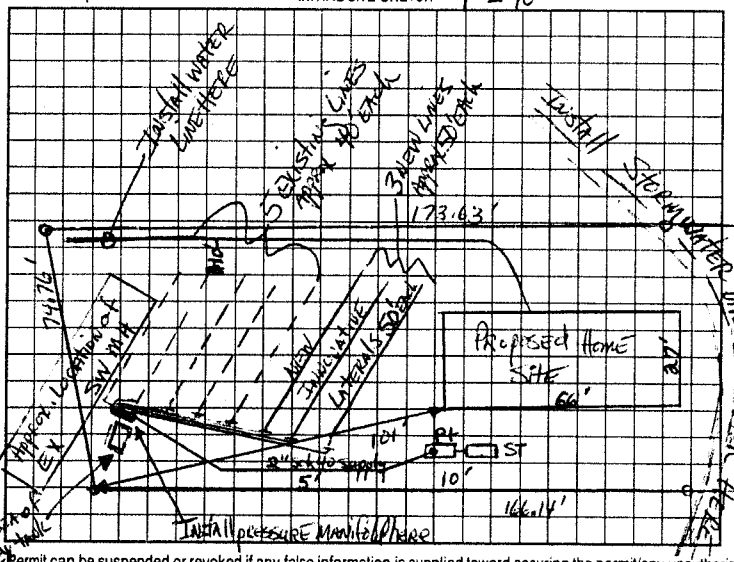

AS BUILT SKETCH

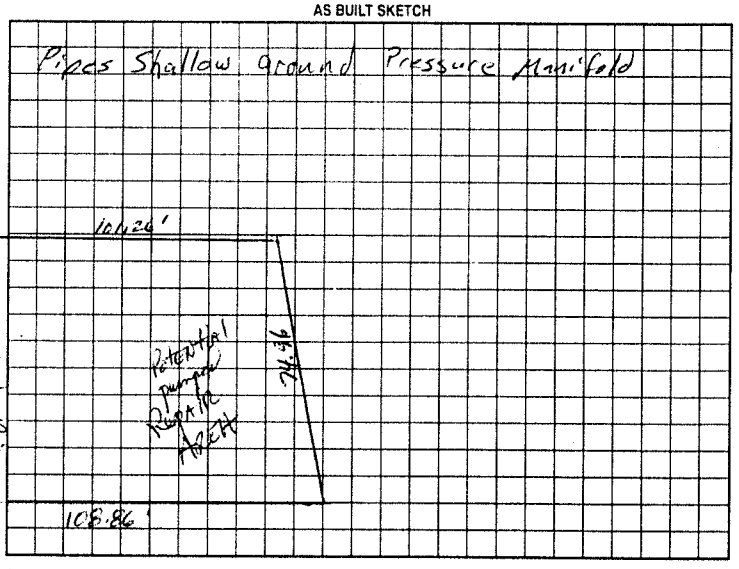

Permit can be suspended or revoked if any false information is supplied toward securing the permit/any unauthorized changes are made to the site/any unauthorized changes are made in the installation of the system. Improvement Permit with plat valid without expiration. Improvement Permit with site plan valid for sixty months. Authorization to Construct is valid for a period equal to that of Improvement Permit – not to exceed sixty months.

Signed: Kathy Whitney date 8/10/00 Installed by: A-1 Backhoe

Improvement Permit by: [signature] date 8-9-2000 Operation Permit by: [signature] RSI date 1/5/01

Authorization to Construct by: [signature] date 8-9-2000 Existing System Inspection by: date

HEALTH DEPT. COPY: WHITE OWNER COPY (FINAL): YELLOW OWNER COPY (INITIAL): PINK