IREDELL COUNTY HEALTH DEPARTMENT

STATESVILLE 704-878-5305 (CT) MOORESVILLE 704-664-5281

IMPROVEMENT PERMIT / AUTHORIZATION TO CONSTRUCT / OPERATION PERMIT / EXISTING SYSTEM INSPECTION

PERMIT# ~~TRADITIONAL~~ 104922 PIN# 4731-68-1390. A DATE 2-13-02

OWNER OR CONTRACTOR BRIAN ARMSTRONG PHONE: Business 704-873-2101 EXT 393 Home

ADDRESS 115 TURTLEDOVE LANE, STATESVILLE, NC 28166

LOCATION US 21 SOUTH, TR GOODMAN ROAD, LOT ON LEFT AT #163

SUBDIVISION BLOCK / SECTION LOT LOT AREA LIMITED SITE CLASS PS DESIGN FLOW 360 L.T.A.R. 0.30 gpd/ft²

Septic Tank: 1000 Gallons; STB 100'7 Date 1-14-02
Pump Tank: Gallons; PT Date
Pump Make: Model Serial No.
Nitrification Field: No Fields 1 Square Feet EQ. TO 1200 Linear Feet 300
No Lines FIVE Trench Width 36" Max Trench Bottom Depth 36" Gravel Depth N/A

☑ New System ☐ Repair System Type: I. II III IV V VI
System Description: 25% REDUCTION, GRAVITY
Repair System Description: 50% REDUCTION, PUMP
Maintenance Agreement Required: ☐ Yes ☑ No
☐ Slab ☑ Crawl Space ☐ Basement w/plumbing ☐ Basement wo/plumbing


☐ House/Mod. Home No. Bedrooms 3
☑ Mobile Home No. Bathrooms 2
☐ Business No. Employees
☐ Other

Water Supply: ☐ Individual ☑ Public ☐ Community

Comments/Conditions:

Comments/Conditions: ① SEPTIC TANK WITH MARKER INSTALLED USING "POLYLOK" FILTER ② SYSTEM INSTALLED DURING MOIST SOIL CONDITIONS

INITIAL SITE SKETCH

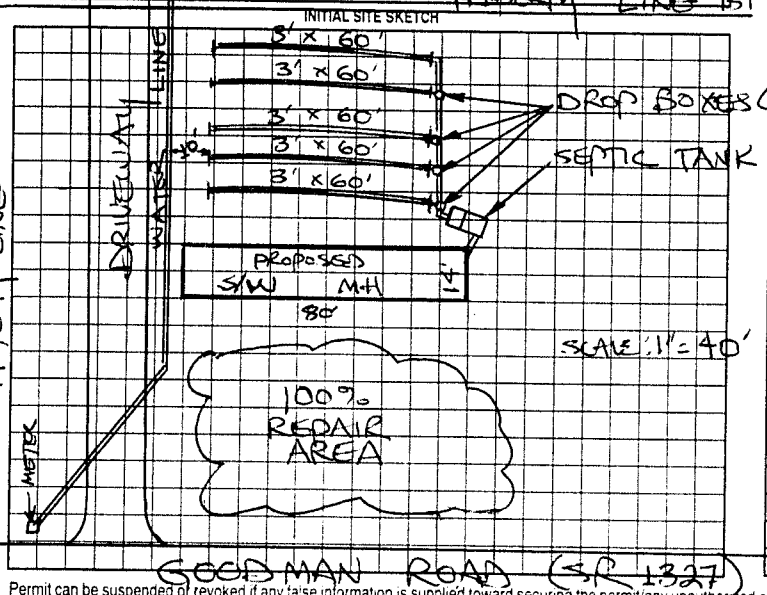

AS BUILT SKETCH

SYSTEM INSTALLED ACCORDING TO INITAL SITE SKETCH

Permit can be suspended or revoked if any false information is supplied toward securing the permit/any unauthorized changes are made to the site/any unauthorized changes are made in the installation of the system. Improvement Permit with plat valid without expiration. Improvement Permit with site plan valid for sixty months. Authorization to Construct is valid for a period equal to that of Improvement Permit – not to exceed sixty months.

Signed: Carol Armstrong date 2-14-02 Installed by: JAMES HUDLER

Improvement Permit by: STEVE HEDRICK date 2-13-02 Operation Permit by: STEVE HEDRICK date 2-21-02

Authorization to Construct by: STEVE HEDRICK date 2-13-02 Existing System Inspection by: date

HEALTH DEPT COPY WHITE OWNER COPY (FINAL) YELLOW OWNER COPY (INITIAL) PINK