* Repair

IREDELL COUNTY HEALTH DEPARTMENT

STATESVILLE 704-878-5305 MOORESVILLE 704-664-5281

IMPROVEMENT PERMIT / AUTHORIZATION TO CONSTRUCT / OPERATION PERMIT / EXISTING SYSTEM INSPECTION

PERMIT # Repair PIN # 4731-68-~~5815~~ 5615 DATE 5 JAN 2010

OWNER or APPLICANT ~~Rebecca~~ Maureen Deppen PHONE: Business Home: (704) 528-1572

OWNER or APPLICANT ADDRESS 150 Goodman Rd. Troutman, NC.

LOCATION / DIRECTIONS * 21 S in Troutman TR Goodman Rd. 1-st past Kerr Drug, 4th House on Rt.

SUBDIVISION BLOCK / SECTION LOT # LOT AREA 0.4Ac. DESIGN FLOW 360gpd L.T.A.R. 0.4/#176

New

Septic Tank 1000 Gallons: STB 1000 Date 10-11-09 | ☐ New System ☑ Repair ☐ Expansion System Type I II (III) IV V VI | ☑ Residence No. Bedrooms 3 | Water Supply: ☑ Private ☐ Public ☐ Community

Pump Tank Gallons: P T Date | System Description: | ☐ Business No. Persons | ☐ Other No. Employees | ☐ Slab ☑ Crawl Space | ☐ Basement w/plumbing ☐ Basement w/o plumbing

Pump Make Model Serial # | Repair System Description: 25% Reduction Syst


Nitrification Field No Fields 1 No Lines 3 Linear Feet 225 | Maintenance Agreement Required ☐ YES ☑ NO

Trench Width 36" Max. Trench Bottom Depth 36" Gravel Depth NA | ☑ GRAVITY ☐ PRESSURE

Comments / Conditions: All plumbing must go into septa tank system. / Properly Abandon old Tank / Follow Contour / * Remove landscaping mesh from entire drain field AREA.

Comments / Conditions: Poly Lock fittings Risers to ST.

INITIAL SITE SKETCH — 1" = 50'

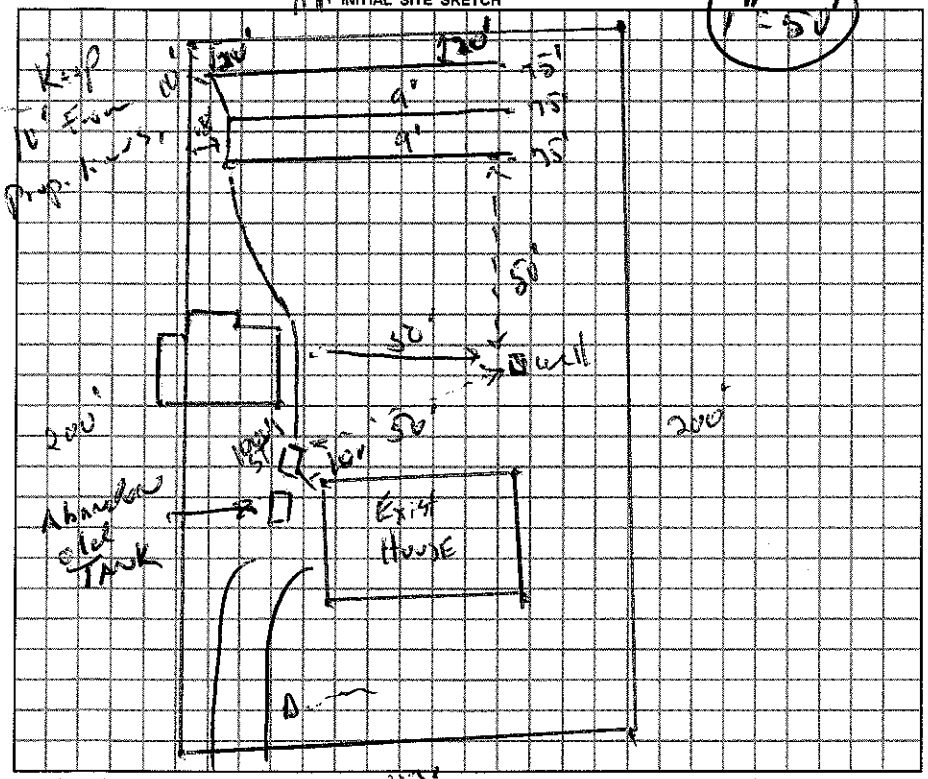

AS BUILT SKETCH

Installed as drawn on site sketch.

Permit can be suspended or revoked if any false information is supplied toward securing the permit / any unauthorized changes are made to the site / any unauthorized changes are made in the installation of the system.

☐ *IMPROVEMENT PERMIT w / plan valid without expiration.* ☑ *IMPROVEMENT PERMIT w / site plan valid for 60 mos.* ☑ *AUTHORIZATION TO CONSTRUCT valid for period equal to IMPROVEMENT PERMIT-not to exceed 60 mo.*

Owner / Applicant Signature: Maureen M Deppen Date

Improvement Permit by: R.S Date 5 JAN 2010

Authorization to Construct by: R.S. Date 5 JAN 2010

Installed by: Johnson Excavation

Operation Permit by: R.S. Date: 7 JAN 2010

Existing System Inspected by: Date:

YOU SHOULD CONTACT A LOCATOR SERVICE PRIOR TO ANY EXCAVATION.

WHITE COPY Environmental Health YELLOW COPY (Final) Owner / Applicant PINK COPY (Initial) Owner / Applicant