IREDELL COUNTY HEALTH DEPARTMENT - *ENVIRONMENTAL HEALTH* ☐ STATESVILLE OFFICE 704-878-5305 ☐ MOORESVILLE OFFICE 704-664-5281

IMPROVEMENT PERMIT / AUTHORIZATION TO CONSTRUCT / OPERATION PERMIT / EXISTING SYSTEM INSPECTION

PERMIT # R40018 PIN # 4731-68-9393 DATE 6 April 2011

OWNER Cheryl T Smith APPLICANT: PHONE: Home/Cell # (704) 528-1067 Business # (704) 682-1629

SITE ADDRESS 129 Goodman Rd. Turnersburg OWNER / APPLICANT ADDRESS

SITE DIRECTIONS Hwy 21S TR Goodman Rd. First brick house on left just Lytton St.

SUBDIVISION BLOCK / SECTION LOT # LOT AREA 1 ac. DESIGN FLOW 360 gpd L.T.A.R. exist.

Septic Tank 1000 gal Gallons: STB 1000 Date

Pump Tank Gallons: PT Date

Pump Make Model Serial #

No. Nitrification Fields: Exist. No. Lines exist. Linear Feet exist.

Trench Width exist. Max. Trench Bottom Depth exist. Gravel Depth

☐ New System ☐ Repair ☐ Expansion System Type I (II) III IV V VI

System Description: Exist. conventional gravity.

Repair System Description:

Maintenance Agreement Required ☐ YES ☒ NO

☐ GRAVITY ☐ PRESSURE

☒ Residence ☐ Business ☐ Other ☐ Slab ☐ Basement w/plumbing


No. Bedrooms 3 No. Persons No. Employees ☐ Crawl Space

Water Supply: ☒ Private ☐ Public ☐ Community

☒ Basement w/o plumbing


Comments / Conditions # Replace exist. septic tank. Properly abandon old tanks.

INITIAL SITE SKETCH

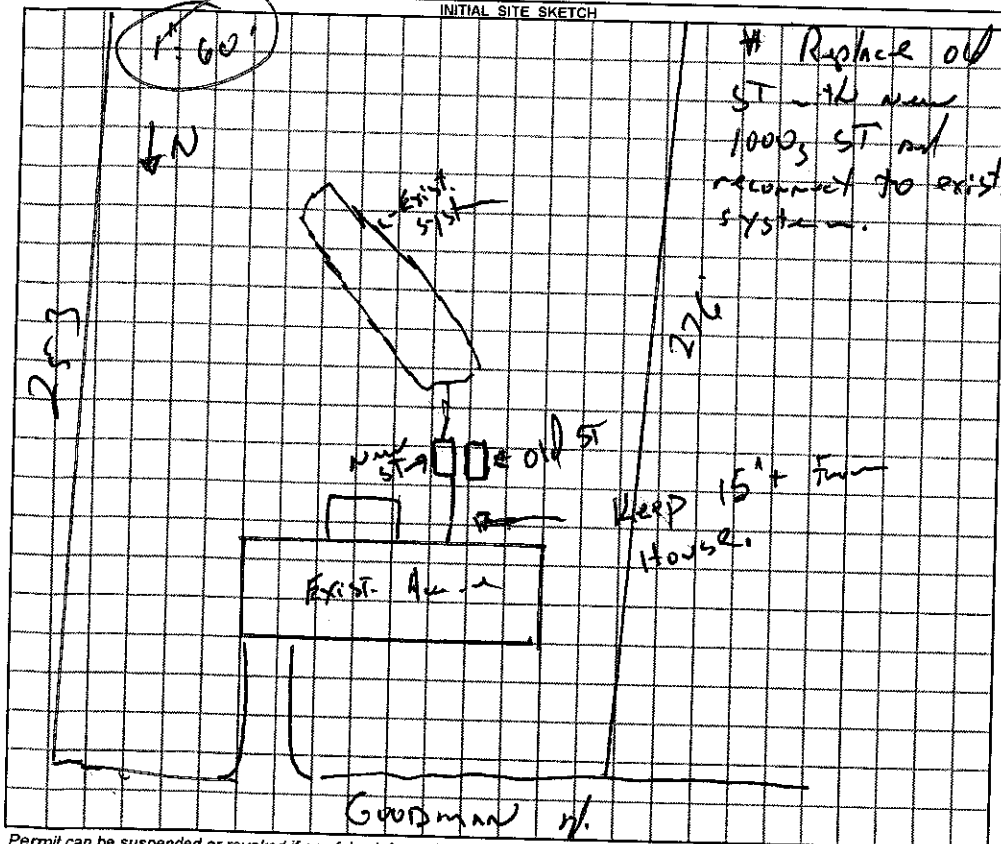

Replace old ST with new 1000 gal ST and reconnect to exist. system.

AS BUILT SKETCH

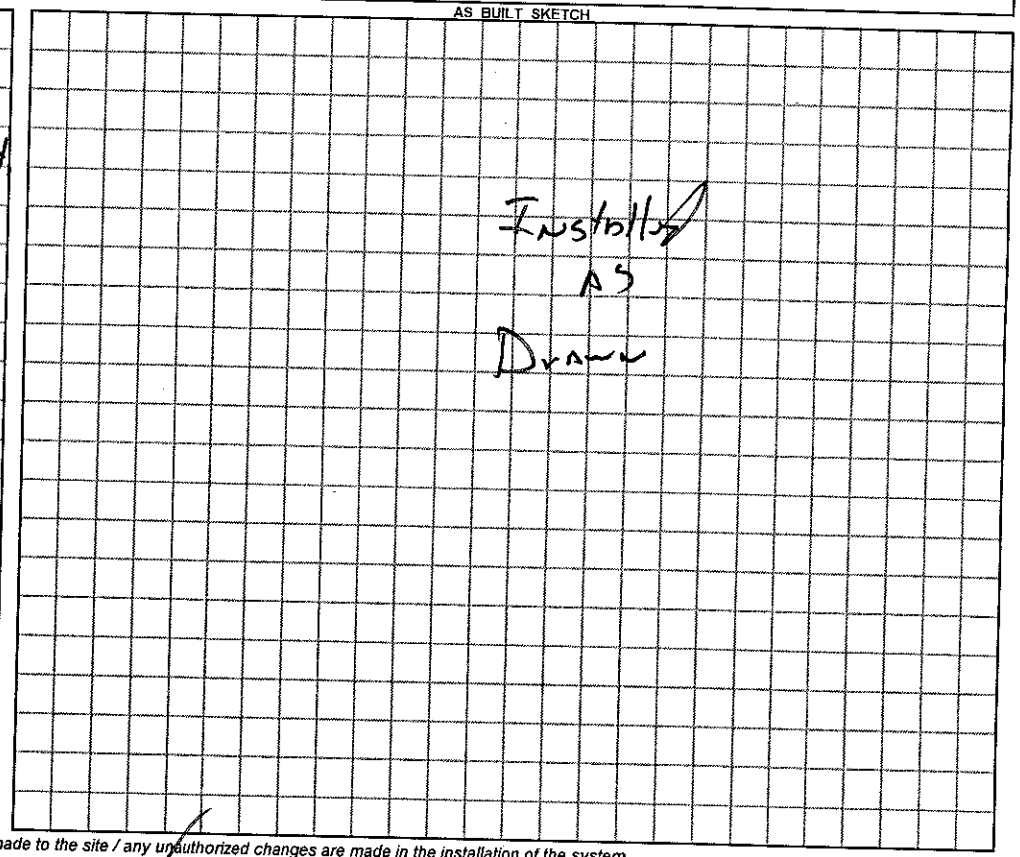

Permit can be suspended or revoked if any false information is supplied toward securing the permit / any unauthorized changes are made to the site / any unauthorized changes are made in the installation of the system.

☐ ***IMPROVEMENT PERMIT*** with plat valid without expiration. ☐ ***IMPROVEMENT PERMIT*** with plat valid without expiration. site plan valid 60 mo. ☒ ***AUTHORIZATION TO CONSTRUCT*** valid for period equal to IMPROVEMENT PERMIT—not to exceed 60 mo.

Owner / Applicant Signature: Cheryl Smith Date 4-6-11 Installed by: Kevin Bowles

IMPROVEMENT PERMIT by: REHS Date

AUTHORIZATION TO CONSTRUCT by: REHS Date 6 April 11 OPERATION PERMIT by: REHS Date 11 April 11

YOU SHOULD CONTACT A LOCATOR SERVICE PRIOR TO ANY EXCAVATION Existing System Inspected by: REHS Date

White Copy – Environmental Health YELLOW COPY (Final) Owner / Applicant PINK COPY (Initial) Owner / Applicant