PERMIT # 170858 PIN # 4731 69 0675

IREDELL COUNTY HEALTH DEPARTMENT – *Environmental Health Division*

Statesville Office 704-878-5305 Mooresville Office 704-660-3625

PRIVATE DRINKING WATER WELL PERMIT

Type of Permit (circle one) (New) Repair Abandonment

APPLICANT INFORMATION

JOHN OGBURN | 10206 VICTORIA BLAKE DR, CORNELIUS, NC | 704-728-2654

Name | Full Address | Telephone #

PROPERTY INFORMATION


US 21 S, TR OLD MOUNTAIN ROAD, TL ORCHARD LANE, HOUSE ON LEFT AT #145

Directions to Site

145 ORCHARD LANE | ORCHARD ACRES | 5

Physical location of proposed well (street address) | Subdivision | Lot #

Initial Site Sketch

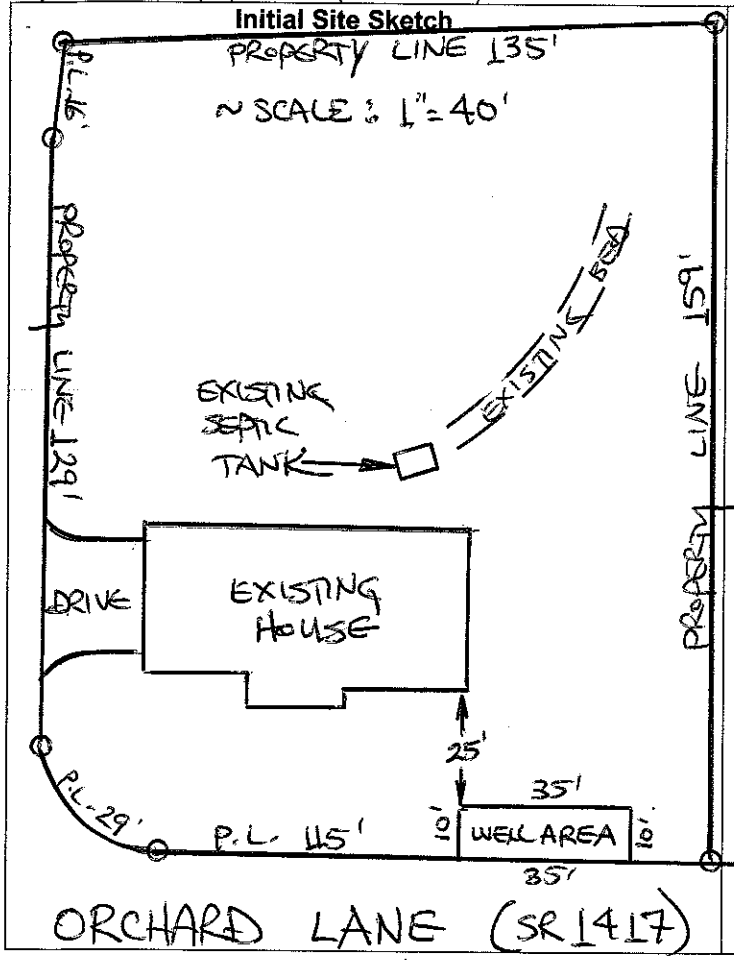

RIGHT-OF-WAY

"As Built" Sketch

Permit Conditions/ Comments: KEEP WELL MAXIMUM FEASIBLE DISTANCE (70 FEET) FROM SEPTIC SYSTEM, 25' FROM BUILDING FOUNDATION

Well Permit Issued By: R. STEVE HEDRICK **Date:** FEBRUARY 24, 2012

(Permit is valid for 5 years from date issued. This permit may be revoked if it is determined there has been a material change in any fact or circumstance upon which the permit is issued. Actions of the employees of the Iredell County Health Department shall in no way be taken as a guarantee that this well will produce water of any particular quantity or quality or for any amount of time. Employees of the Iredell County Health Department assume no liability for any damages, either direct or consequential which may be caused by this well.)

Well GPS Coordinates Lat: _____ **Long:** _____ **Well Contractor** Rowan **Contractor Cert #** 2522

Grout Inspection By: [signature] **Date:** 4-18-12 **or Certification for Grouting Not Witnessed**

by Dept _____ **Date:** _____ **Well Head Inspection** (check when completed) Grout to Ground Surface ☐

Well Contractor ID Plate ☑ Pump Installer ID Plate ☑ Sample Port ☐ Access Port / Vent ☑ Well Seal ☑ Well Head 12 inches / Pit less Adaptor 8 inches above grade ☑ **Well Head Inspection By:** [signature] **Date:** 11-19-2012

Certificate of Completion by: [signature] **Date:** 11-19-2012 **Water Samples By:** [signature] **Date:** 12-5-12

Attachments: Form GW-1a (***required except for abandonment***) ☐ Form GW 30 ☑ Water Sample Results ☐ Plat ☐

Health Dept. Copy - White Applicant Certificate of Completion - Yellow Applicant Well Construction Permit - Pink