IREDELL COUNTY HEALTH DEPARTMENT

Statesville Office (704) 878-5305 Mooresville Office (704) 660-3625 PERMIT # 222400

IMPROVEMENT PERMIT / AUTHORIZATION TO CONSTRUCT / OPERATION PERMIT / EXISTING SYSTEM

PIN # 4731-70-3402

APPLICANT: Glenn Weber APPLICANT ADDRESS: 765 Perth Rd. Troutman, NC

SITE ADDRESS: 106 Weddington Road LN Troutman, NC 28166 PHONE: 704-528-1394 ALT. PHONE:

SITE DIRECTIONS: Perth Rd N from Rt 150 → L on Weddington Rd → 1st house on Right


SUBDIVISION: — SECTION: — LOT # — LOT AREA: 2.00 acres DESIGN FLOW: 240 GPD L.T.A.R.: —

Septic Tank	1000	(gal)	STB	760	Date	8/23/16	☐ New System	☒ Repair	☐ Expansion	System Type: I (II) III IV V VI	
Pump Tank	—	(gal)	PT		Date		System Description:	Replace collapsing septic			
Pump Make	—	Model	—		Serial #	—	Repair System Description:	tank as needed			
# Nitrification Fields	Ex	# Lines	Ex		Linear Ft:	Ex	Maintenance Agreement Required:	☐ YES	☒ NO		
Trench Width	Ex	Max. Trench Bottom Depth	Ex		Gravel Depth	Ex	☒ GRAVITY	☐ PRESSURE			

☒ Residence	No. Bedrooms	2	Water Supply	
☐ Business	No. Persons	4	☐ Private	
☐ Other	No. Employees		☒ Public	
☐ Slab	☒ Crawl Space		☐ Community	
☐ Basement w/plumbing	☐ Basement w/o plumbing			

Comments / Conditions: Follow all N.C. septic rules. Existing septic tank must be pumped, limed and crushed in place. Recommend pumping new septic tank every 3-5 years.

INITIAL SITE SKETCH

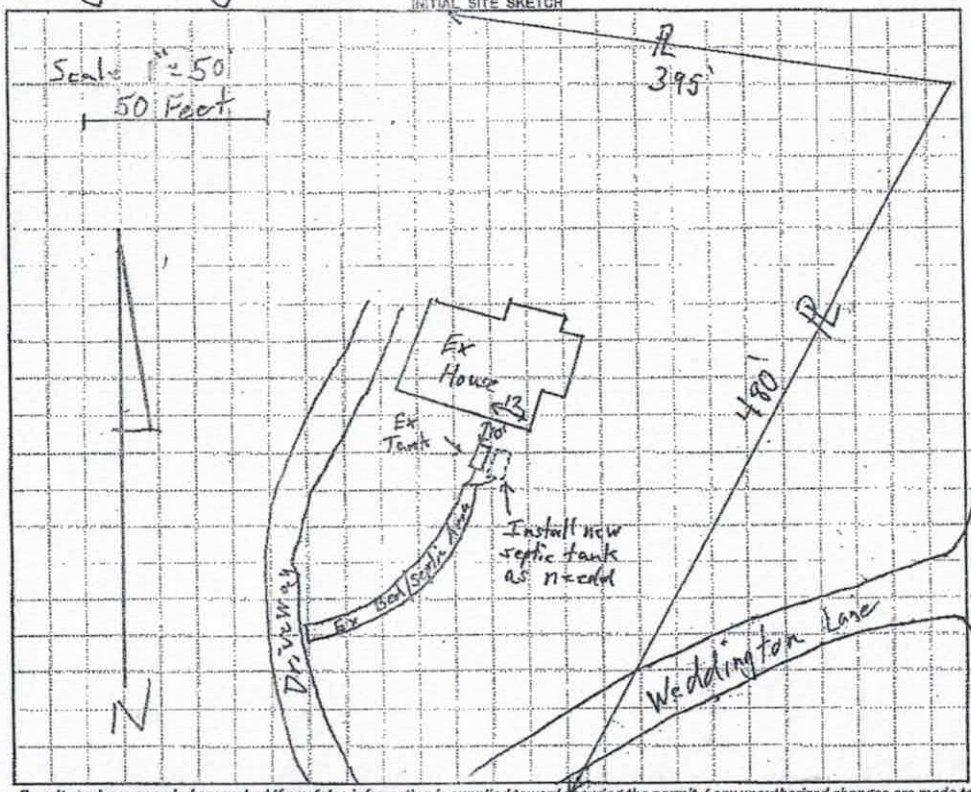

AS BUILT SKETCH

Permit can be suspended or revoked if any false information is supplied toward securing the permit / any unauthorized changes are made to the site / any unauthorized changes are made in the installation of the system. CONTACT A LOCATOR SERVICE PRIOR TO ANY EXCAVATION

☐ IMPROVEMENT PERMIT with plat valid without expiration. ☒ IMPROVEMENT PERMIT with site plan valid for 60 mos. ☒ AUTHORIZATION TO CONSTRUCT valid for period equal to IMPROVEMENT PERMIT--not to exceed 60 mo.

Owner / Applicant Signature: Glenn Weber Date: 10-12-2016 Installed by: Henry Wastewater WI Specs

IMPROVEMENT PERMIT by: Tom Shuck Date: 10-11-2016 OPERATION PERMIT by: Date: 10/19/16

AUTHORIZATION TO CONSTRUCT by: Tom Shuck Date: 10-11-2016 Existing System Inspected by: Date:

Health Dept. Copy - WHITE Applicant (Final Approval) - YELLOW Applicant (Conditional Approval) - PINK