IREDELL COUNTY HEALTH DEPARTMENT

Statesville Office (704) 878-5305 Mooresville Office (704) 660-3625 PERMIT # 213842

IMPROVEMENT PERMIT / AUTHORIZATION TO CONSTRUCT / OPERATION PERMIT / EXISTING SYSTEM

PIN # 473 | 705 953

APPLICANT: Mary Lois Walker APPLICANT ADDRESS: 742 Perth Rd Troutman NC 28166

SITE ADDRESS: 742 Perth Rd Troutman NC 28166 PHONE: 704-528-6272 ALT. PHONE: N/A


SITE DIRECTIONS: 1155 T/R Perth Rd Lot on right

SUBDIVISION: N/A SECTION: N/A LOT # N/A LOT AREA: 0.61ac DESIGN FLOW: Ex L.T.A.R.: Ex


Septic Tank	Ex (gal)	STB	760	Date	5-29-15	☐ New System ☐ Repair ☐ Expansion System Type: I ☒ II III IV V VI	☒ Residence	No. Bedrooms	Ex
Pump Tank	N/A (gal)	PT	N/A	Date	N/A	System Description: Tank	☐ Business	No. Persons	Ex
Pump Make	N/A	Model	Polylok	Serial #	PL-68	Repair System Description:	☐ Other	No. Employees	
# Nitrification Fields	Ex	# Lines	Ex	Linear Ft:	Ex	Maintenance Agreement Required: ☐ YES ☒ NO	☐ Slab	☑ Crawl Space	Water Supply: ☐ Private ☑ Public ☐ Community
Trench Width	Ex	Max. Trench Bottom Depth	Ex	Gravel Depth	Ex	☒ GRAVITY ☐ PRESSURE	☐ Basement w/plumbing	☐ Basement w/o plumbing	

Comments / Conditions: Maintain 5' off any building Foundation with new tank

INITIAL SITE SKETCH

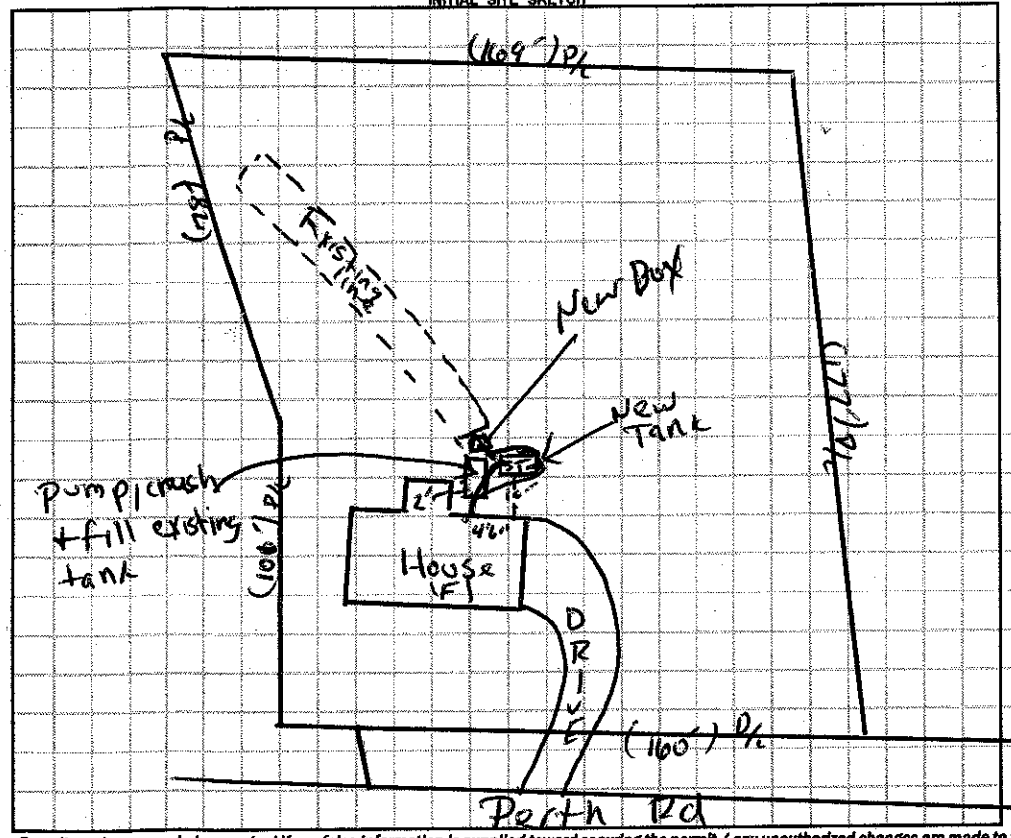

AS BUILT SKETCH

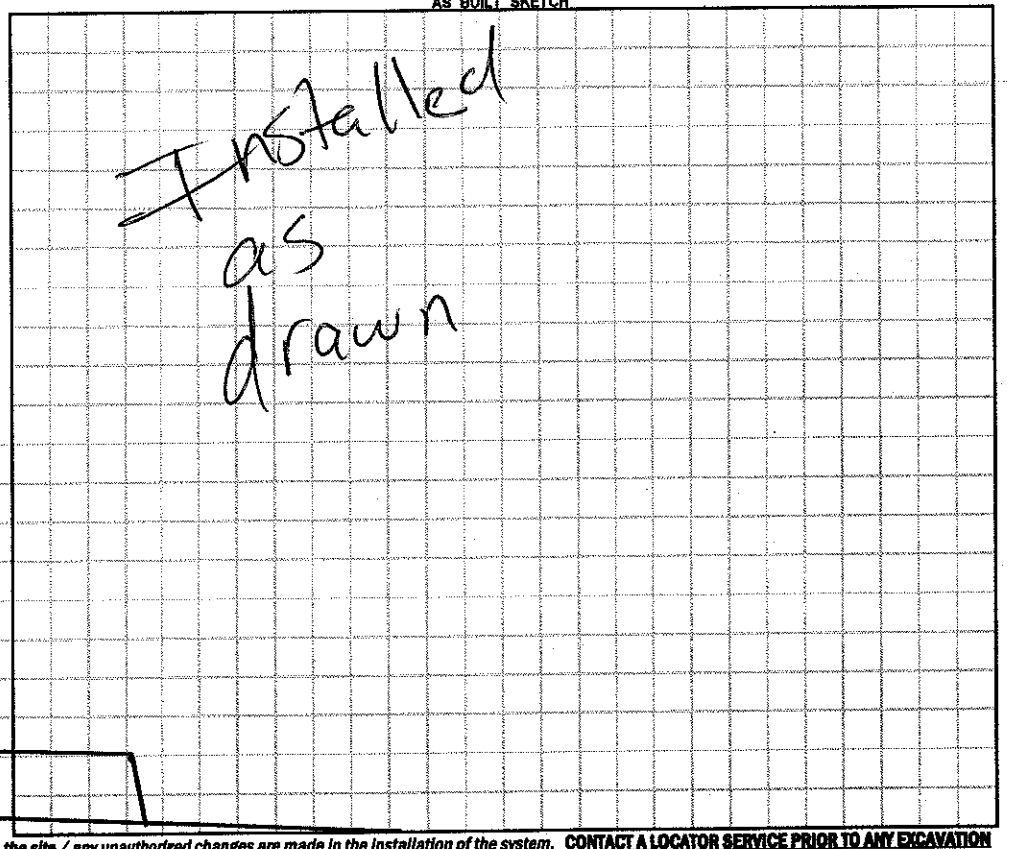

Permit can be suspended or revoked if any false information is supplied toward securing the permit / any unauthorized changes are made to the site / any unauthorized changes are made in the installation of the system. **CONTACT A LOCATOR SERVICE PRIOR TO ANY EXCAVATION**

☐ **IMPROVEMENT PERMIT** *with plat valid without expiration.* ☒ **IMPROVEMENT PERMIT** *with site plan valid for 60 mos.* ☑ **AUTHORIZATION TO CONSTRUCT** *valid for period equal to IMPROVEMENT PERMIT--not to exceed 60 mo.*

Owner / Applicant Signature: Mary L Walker Date: 9-29-2015 Installed by: Lentz Septic

IMPROVEMENT PERMIT by: [signature] Date: 09/29/15 OPERATION PERMIT by: [signature] Date: 10/05/15

AUTHORIZATION TO CONSTRUCT by: [signature] Date: 09/29/15 Existing System Inspected by: Date:

Health Dept. Copy - WHITE Applicant (Final Approval) - YELLOW Applicant (Conditional Approval) - PINK