IREDELL COUNTY HEALTH DEPARTMENT

Statesville Office (704) 878-5305 Mooresville Office (704) 660-3625 PERMIT # 228865

SEPTIC IMPROVEMENT PERMIT / AUTHORIZATION TO CONSTRUCT / OPERATION PERMIT / EXISTING SYSTEM

PIN # 4731771848

APPLICANT/OWNER: Brenda Yates Taylor APPLICANT ADDRESS: 3509 Flint Dr

SITE ADDRESS: 114 Candice Ln Troutman NC PHONE: 704-682-1594 ALT. PHONE 704-873-4665

SITE DIRECTIONS: 21 N T/L Talley Rd T/R Lytton St T/L Candice Ln SAP CONTROLLED: ☐ YES ☐ NO

SUBDIVISION: N/A SECTION: N/A LOT # N/A LOT AREA: 0.67ac DESIGN FLOW: Ex L.T.A.R.: Ex

Septic Tank 1000 (gal) STB 760. Date 5/30/17 ☐ New System ☒ Repair ☐ Expansion System Type: I II III IV V VI

Pump Tank ____ (gal) PT ____ Date ____ System Description: Tank

Pump Make ____ Model ____ Serial # ____ Repair System Description: ____

Nitrification Fields Ex # Lines Ex Linear Ft Ex Maintenance Agreement Required: ☐ YES ☒ NO

Trench Width Ex Trench Bottom Depth(Low side) Ex Gravel Depth Ex ☒ GRAVITY ☐ PRESSURE

☒ Residence No. Bedrooms Ex

☐ Business No. Persons Ex

☐ Other No. Employees ____


☐ Slab ☐ Crawl Space

☐ Basement w/plumbing ☒ Basement w/o plumbing


Water Supply: ☐ Private ☒ Public ☐ Community

Comments / Conditions: Pump & crush & fill existing tank. Use risers to maintain no greater than 6" of cover. Do not exceed 36" of cover

INITIAL SITE SKETCH

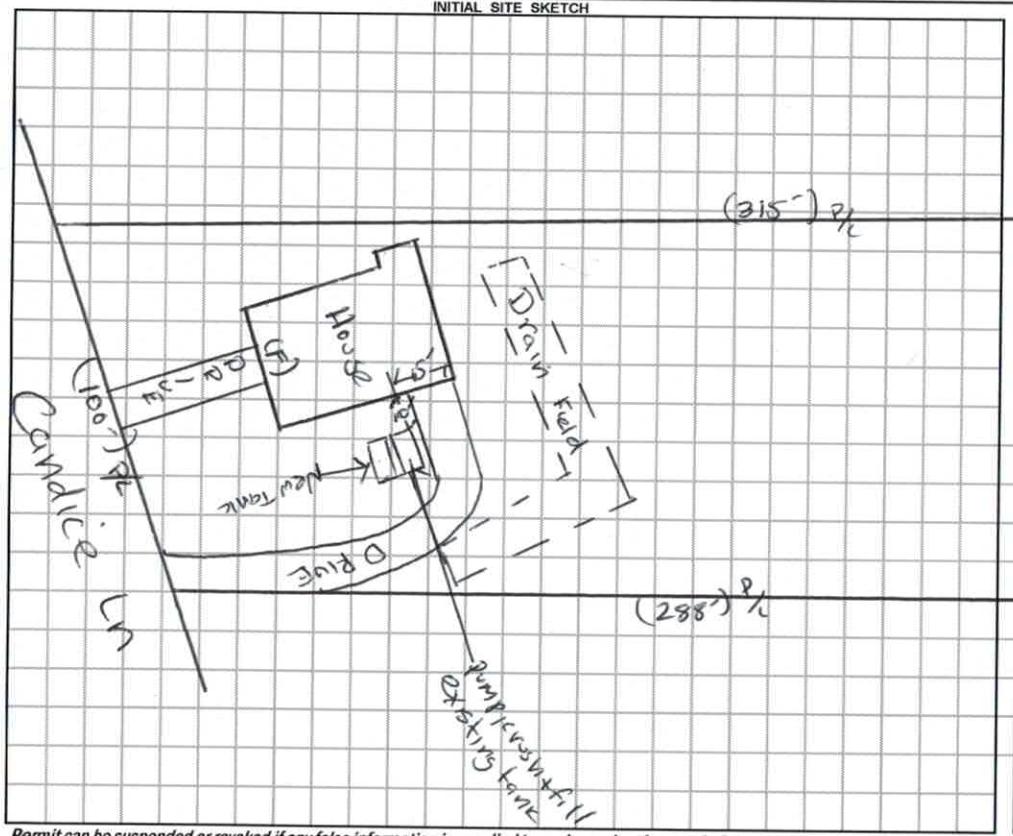

AS BUILT SKETCH

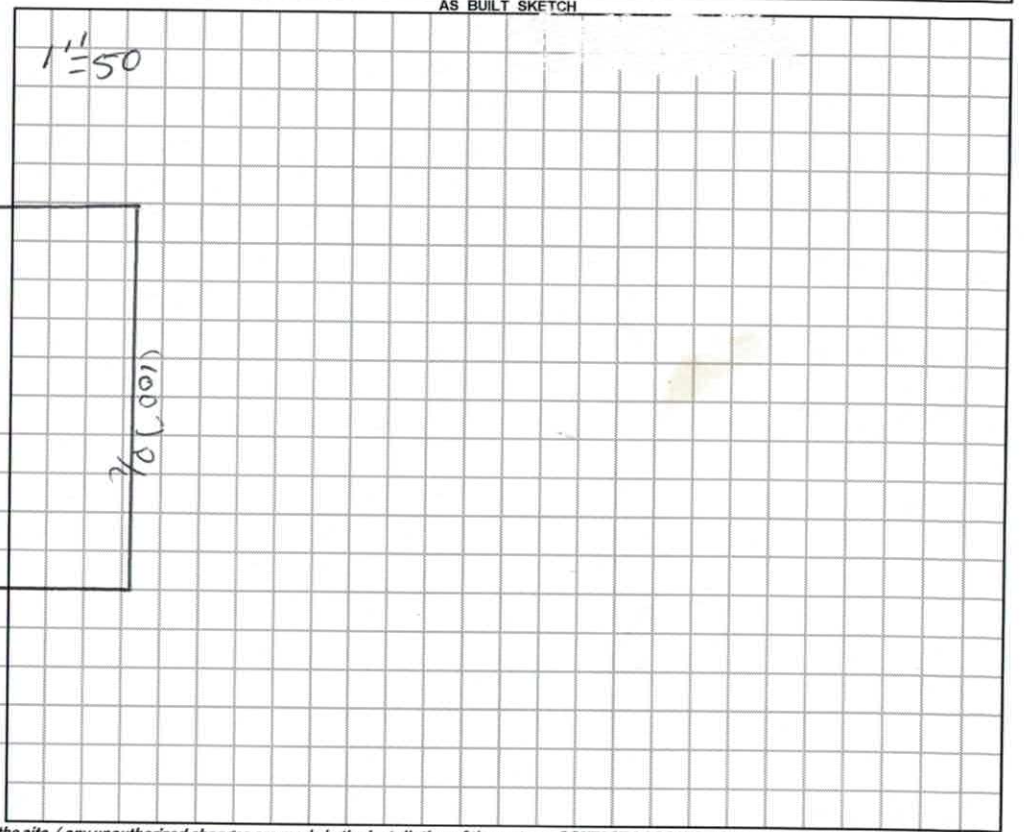

Permit can be suspended or revoked if any false information is supplied toward securing the permit / any unauthorized changes are made to the site / any unauthorized changes are made in the installation of the system. **CONTACT A LOCATOR SERVICE PRIOR TO ANY EXCAVATION**

☐ **IMPROVEMENT PERMIT** ***with plat*** *valid without expiration.* ☒ **IMPROVEMENT PERMIT** ***with site plan*** *valid for 60 mos.* ☒ **AUTHORIZATION TO CONSTRUCT** *valid for period equal to IMPROVEMENT PERMIT--not to exceed 60 mo.*

Owner / Applicant Signature: Pd by B. Taylor - typed to Lentz Date: 7/25/17 Installed by: David Lentz Wastewater

IMPROVEMENT PERMIT by: Date: 07/25/17 OPERATION PERMIT by: Benjamin A. Bates Date: 8/3/17.

AUTHORIZATION TO CONSTRUCT by: Date: 07/25/17 Existing System Inspected by: Date:

IREDELL COUNTY HEALTH DEPARTMENT *ENVIRONMENTAL HEALTH DIVISION*

PAGE 1: *APPLICATION FORM*

Application For: ( ) New Well Permit ( ) Well Repair Permit ( ) Well Abandonment
( ) Septic Improvement Permit ( ) Authorization to Construct ( ) Existing System Inspection (✓) Septic System Repair

THE ABOVE PERMIT DOCUMENTS WILL BECOME INVALID IF INFORMATION PROVIDED ON THIS APPLICATION IS FALSIFIED OR CHANGED, OR IF THE SITE IS ALTERED. THE IMPROVEMENT PERMIT IS VALID FOR EITHER 60 MONTHS OR WITHOUT EXPIRATION DEPENDING UPON DOCUMENTATION SUBMITTED. APPLICATION WITH SITE PLAN 60 MONTHS, APPLICATION WITH COMPLETE, SCALED PLAT WITHOUT EXPIRATION. SEE 15A NCAC 18A .1937(f) FOR DETAILS.

Page 2: *Site Plan Worksheet* form MUST accompany this application

The following optional attachments may also be submitted: ( ) Survey Plat, scaled no more than 1 inch = 60 feet
Place an (X) beside whichever is submitted if applicable ( ) Custom Site Plan, scaled no more than 1 inch = 60 feet

Applicant Information: (PRINT CLEARLY) PLEASE CALL 704-682-1594

Applicant Name: BRENDA YATES TAYLOR Address: 3509 FLINT DR Zip: 28677
Applicant Email: bjcyates@yahoo.com Phone: 704-682 1594 Alt. Phone: 7048934665
Owner Name: BRENDA YATES TAYLOR Address: _____ Zip: _____
Owner Email: _____ Phone: _____ Alt. Phone: _____

Property Information:

Street Address: 114 CANDICE LANE TROUTMAN, NC 28166
Subdivision Name: _____ Section/Phase: _____ Lot Number: _____
Driving Directions: _____

Site Development Information: *(check or complete ALL that apply*

( ) New Single Family Residence
( ) New Multi-Family Residence
( ) Accessory Building
( ) Bedroom(s) Addition
(✓) Repair to failing septic system 1 Tank ___ Drain lines Describe Problem: _____
Non-Residential Site Development: Type of Business: _____
Square Footage of Building: 1800 Max. Number of Employees: ____ Max. Number of Seats/Beds/Other: ____

Maximum Number of Bedrooms: 4
Maximum Number of Occupants: 7
( ) Swimming Pool
( ) Other Addition/Structure: _____

CHECK FOUNDATION TYPE
( ) Crawl Space Foundation
( ) Concrete Slab Foundation
(✓) Basement with Plumbing
( ) Basement without Plumbing

Water Supply: ( ) Replacement Well – Reason: _____
( ) Multi-connection Well Number of Houses: _____ Number of Persons: _____
( ) New Well ( ) Existing Well ( ) Community Well (✓) City Water ( ) Other Public Water

Desired Septic System Type: *(you may rank in order of preference)* Year existing system installed: _____
( ) No Preference ( ) Alternative ( ) Conventional ( ) Innovative ( ) Modified Conventional ( ) Other: _____

Please answer the following to the best of your ability:
( ) Yes ( ) No Does the site contain any jurisdictional wetlands?
( ) Yes ( ) No Is any non-domestic sewage (i.e. industrial) to be generated?
( ) Yes ( ) No Is the site subject to approval by any other public agency?

I have read this application and certify that the information provided herein is true, complete, and correct. Authorized county and state officials are granted right of entry to conduct necessary inspections to determine compliance with applicable laws and rules. I understand that I am solely responsible for the proper identification and labeling of all property lines and corners and making the site accessible so that a complete site evaluation can be performed.

Signature: Brenda Yates Taylor 7-21-17
Property owner or owner's legal representative signature (SIGNATURE REQUIRED) DATE

228865

IREDELL COUNTY DEPARTMENT OF ENVIRONMENTAL HEALTH

DOCUMENTATION TO AUTHORIZE AN OWNER'S LEGAL REPRESENTATIVE

Applications for permits require the "signature of the owner or owner's legal representative" (15A NCAC 18A .1937). If the owner does not sign the application himself or herself, they can submit any one of the following documents to designate their legal representative:

Power of Attorney; Real Estate Contract; Estate executor; Bankruptcy trustee; Court ordered guardianship

In the absence of the above documentation, the property owner may provide the local health department with documentation that designates a legal representative. A property owner may:

Complete this form to document his or her legal representative, or provide his or her own form that contains the information in this form.

If there are multiple property owners, then all property owners must sign the form that designates a legal representative.

By signing a form that designates a legal representative for purposes of 15A NCAC 18A .1937, the property owner authorizes that representative to act on their behalf in matters pertaining to the application and permitting process, including signing or receiving any application, document or permit. The owner retains full responsibility to meet all permit conditions specified by the local health department.

I, BRENDA YATES TAYLOR, am the legal owner(s) of the property located at 114 CANDICE LANE TROUTMAN, NC, identified as PIN (Parcel Identification Number) _____, located in Iredell County, North Carolina.

I do hereby authorize **(print legal representative/company name)** _____, _____, to act as an agent on my behalf in applying for/signing/obtaining any of the documents described below.

- Application for Improvement Permit (IP) / Authorization to Construct (AC)
- Improvement Permit (IP) / Authorization to Construct (AC)
- Application for soil-site evaluation (new/repair)
- Application/permit for private drinking water well/well abandonment
- Application for Compliance Inspection

I agree to abide by all decisions and/or conditions between the legal representative acting on my behalf and the Iredell County Department of Public Health, Environmental Health Division.

Brenda Yates Taylor 1-21-17

Signature of Owner(s) Date

_____ _____

Signature of Witness Date

Please return this signed form to the appropriate office:

Mooresville - Environmental Health
ronda.hart@co.iredell.nc.us
Fax: 704-662-3239
610 E. Center Avenue, Mooresville, NC 28115

Statesville - Environmental Health
adrienne.shea@co.iredell.nc.us
Fax: 704-871-3483
349 N. Center Street, Statesville, NC 28677

IREDELL COUNTY HEALTH DEPARTMENT


ENVIRONMENTAL HEALTH DIVISION

PAGE 2: *SITE PLAN WORKSHEET*

SEE THE "SAMPLE SITE PLAN" BELOW. *INCOMPLETE SITE PLANS WILL BE RETURNED TO YOU FOR COMPLETION AND MAY RESULT IN A DELAY IN THE ISSUANCE OF YOUR SEPTIC SYSTEM PERMIT!!!*

Place an (X) beside each item as you complete the site plan:

( ) Property Line measurements are clearly identified
( ) All proposed structures are indicated
( ) Front and side setbacks from property line
( ) Preferred driveway location and well location
( ) Area you prefer your septic system to be placed
( ) North arrow, or other sufficient indicator of direction

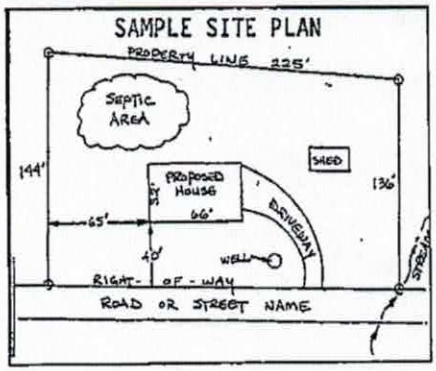


Circle N/A on the following if appropriate:

Location of septic systems and wells within 100' of your property	N/A
Location of easements and rights of ways on your property	N/A
Location of any designated wetlands on the property	N/A

USE THIS SPACE TO DRAW YOUR SITE PLAN

Show: proposed house or business footprint, wells, water lines, patios, pools and decks, and any other item that will occupy space on the site

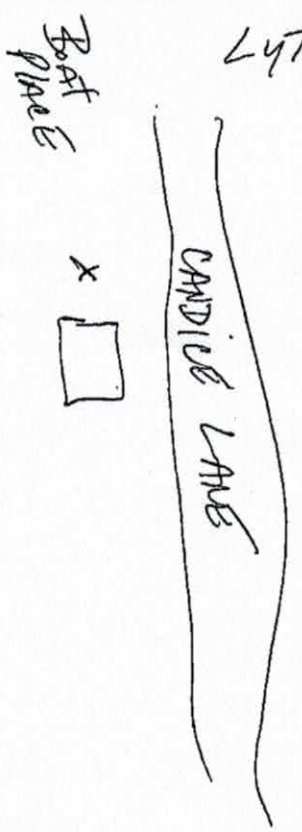

Signature: Brenda Yates Taylor
Property owner or owner's legal representative signature (SIGNATURE REQUIRED)

7-21-17
DATE