IREDELL COUNTY HEALTH DEPARTMENT

Statesville Phone TR 3-7271 Mooresville Phone NO 3-1271

PERMIT TO INSTALL SEPTIC TANK

Permit NO. 288 Permit Date Apr. 26 1971

Owner MIKE BRANNON Address Troutman N.C.

Installed By OSTWALT Address Troutman. N.C.


Location of Property TROUTMAN - RIGHT ON PERTH Church Rd - #1303 LEFT ON Road # 1320 - THEN RIGHT ON Road # 1126

Tank		Capacity		Length of Lines		Fixtures	
Block	( )	1000	(✓)	225'	(✓)	No. of Baths	(1½
Precast	(✓)	1250	( )	250:	( )	Dishwasher	( )
		1500	( )	Other		Garbage Grdr.	( )
		Other				Other	

NOTIFY HEALTH DEPARTMENT AT LEAST EIGHT HOURS BEFORE TANK IS TO BE INSPECTED.

Final Inspection April 29 1971 Approved (✓) Disapproved ( )

Remarks

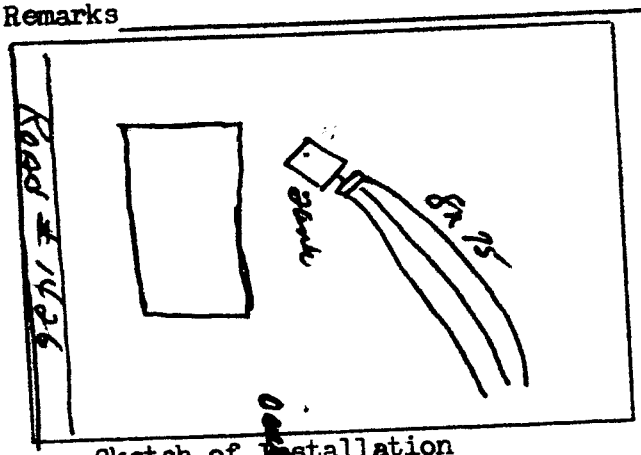

Sketch of Installation

Glenn Todd

Sanitarian