IREDELL COUNTY HEALTH DEPARTMENT

Statesville Office (704) 878-5305 Mooresville Office (704) 660-3625 PERMIT # 179603

IMPROVEMENT PERMIT / AUTHORIZATION TO CONSTRUCT / OPERATION PERMIT / EXISTING SYSTEM

PIN # 4731920458

APPLICANT: Freddy L & Renee C Harkey APPLICANT ADDRESS: 530 Lake Circle

SITE ADDRESS: 530 Lake Circle PHONE: 704 902 5209 ALT. PHONE:

SITE DIRECTIONS: Perth Church Rd. South to ERA Street on ~~Goodes~~ (R) on Lake Circle 1st house on (R)

SUBDIVISION: n/a SECTION: n/a LOT # n/a LOT AREA: .98 (2 lots) DESIGN FLOW: 360 L.T.A.R.: .25

Septic Tank ex (gal) STB Date

Pump Tank (gal) PT Date

Pump Make Model Serial #

Nitrification Fields 1 # Lines 3 Linear Ft: 360

Trench Width 36" Max. Trench Bottom Depth 36" Gravel Depth n/a

☐ New System ☒ Repair ☐ Expansion System Type: I II (III) IV V VI

System Description:

Repair System Description: 25% Reduction Gravity

Maintenance Agreement Required: ☐ YES ☒ NO

☒ GRAVITY ☐ PRESSURE

☒ Residence ☐ Business ☐ Other ☐ Slab ☒ Basement w/plumbing


No. Bedrooms 3 No. Persons No. Employees ☐ Crawl Space

Water Supply: ☐ Private ☒ Public ☐ Community

☐ Basement w/o plumbing

Comments / Conditions: Easement has been recorded for crossing property line. Add 3 drop boxes and 120' of line Endcap distribution also acceptable

INITIAL SITE SKETCH

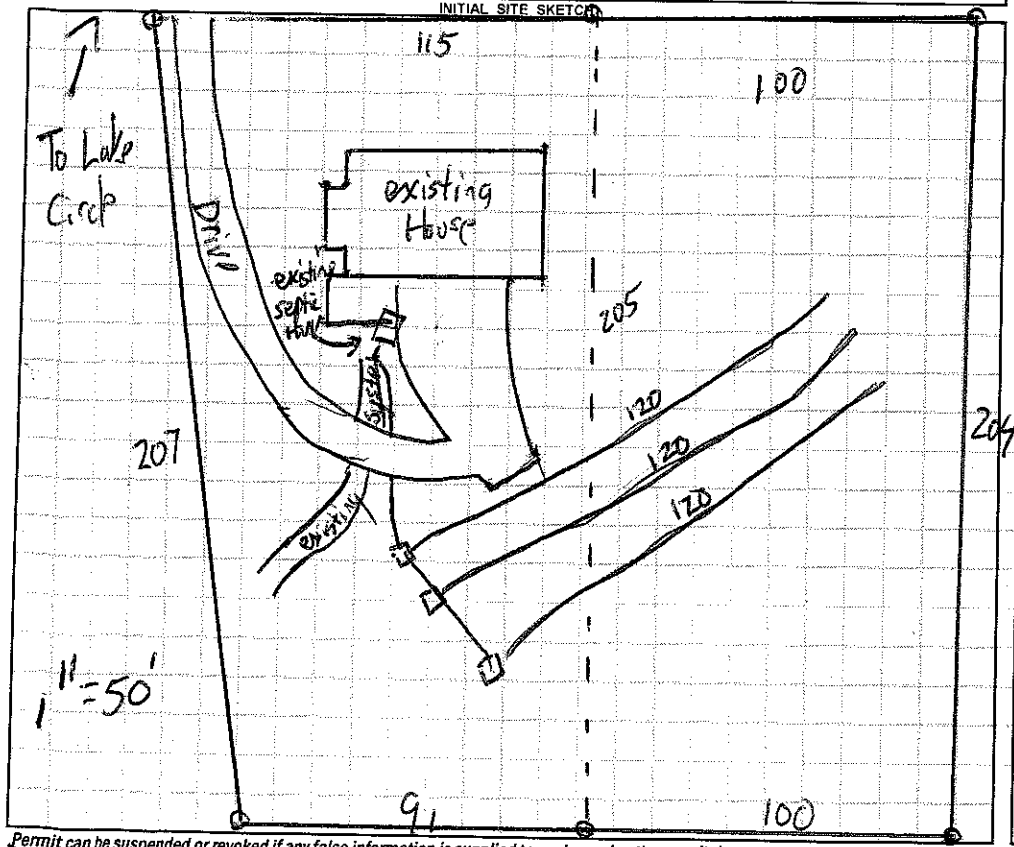

AS BUILT SKETCH

If existing supply line cannot be used, then sleeve supply line in sch 80 under drive

Permit can be suspended or revoked if any false information is supplied toward securing the permit / any unauthorized changes are made to the site / any unauthorized changes are made in the installation of the system. **CONTACT A LOCATOR SERVICE PRIOR TO ANY EXCAVATION**

☒ **IMPROVEMENT PERMIT** *with plat valid without expiration.* ☒ **IMPROVEMENT PERMIT** *with site plan valid for 60 mos.* ☐ **AUTHORIZATION TO CONSTRUCT** *valid for period equal to IMPROVEMENT PERMIT--not to exceed 60 mo.*

Owner / Applicant Signature: Fred Harkey Date: 8-21-13 Installed by: Piedmont Grading

IMPROVEMENT PERMIT by: James Date: 8-14-13 OPERATION PERMIT by: James Date: 9-6-13

AUTHORIZATION TO CONSTRUCT by: James Date: 8-14-13 Existing System Inspected by: Date:

Health Dept. Copy - WHITE Applicant (Final Approval) - YELLOW Applicant (Conditional Approval) - PINK