93621

IREDELL COUNTY HEALTH DEPARTMENT

STATESVILLE 704-878-5305 MOORESVILLE 704-664-5281

IMPROVEMENT PERMIT / AUTHORIZATION TO CONSTRUCT / OPERATION PERMIT / EXISTING SYSTEM INSPECTION

PERMIT# 08-2-1000 PIN# 4731 922 357 DATE 11-9-00

OWNER OR CONTRACTOR James Paul Lintsey PHONE: Business 664 7223 Home

ADDRESS 535 Lake Circle Troutman N.C.

LOCATION 215 TR Rumple TL Era TR Lake Circle 500' left

SUBDIVISION BLOCK / SECTION LOT LOT AREA .72 acres SITE CLASS PJ DESIGN FLOW 360 L.T.A.R. .35


Septic Tank: 1000 Gallons, STB 794 Date 4-16-01
Pump Tank: Gallons, PT Date
Pump Make: Model Serial No
Nitrification Field: No Fields 1 Square Feet 1080 Linear Feet 360
No Lines 3 Trench Width 36" Max Trench Bottom Depth 34" Gravel Depth 12"

☑ New System ☐ Repair System Type I (II) III IV V VI
System Description: Conv. Community
Repair System Description: 25% Reduction
Maintenance Agreement Required: ☐ Yes ☑ No
☐ Slab ☐ Crawl Space ☑ Basement w/plumbing ☐ Basement wo/plumbing


☑ House/Mod. Home No. Bedrooms 3
☐ Mobile Home No. Bathrooms 2
☐ Business No. Employees
☐ Other

Water Supply: ☐ Individual ☑ Public ☐ Community

Comments/Conditions

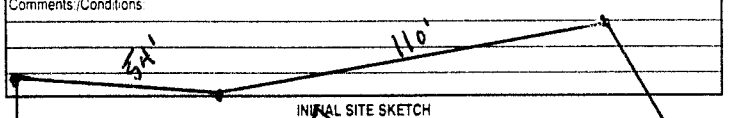


INITIAL SITE SKETCH

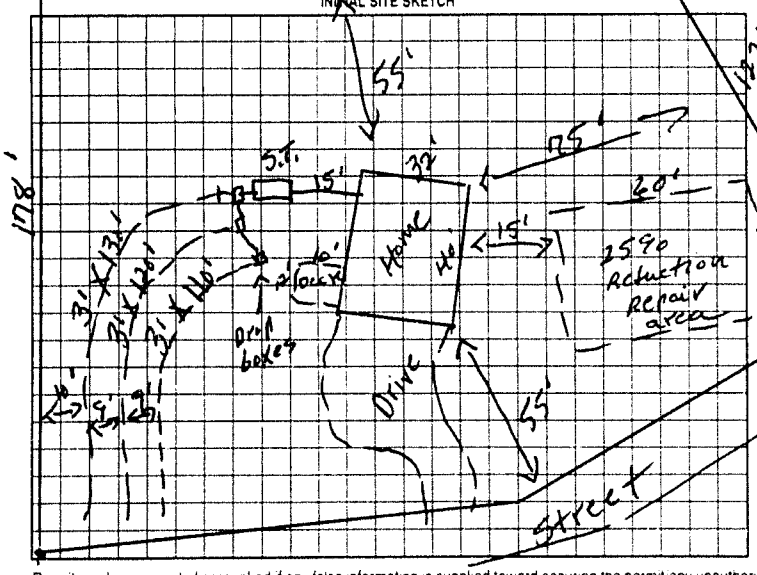

Comments/Conditions Pumping basement Plumbing up To level of Septic Tank
(- Zoeller Filter ; 4" Pvc Riser Installed)

AS BUILT SKETCH - Top Trench deeper than 24" to bottom.

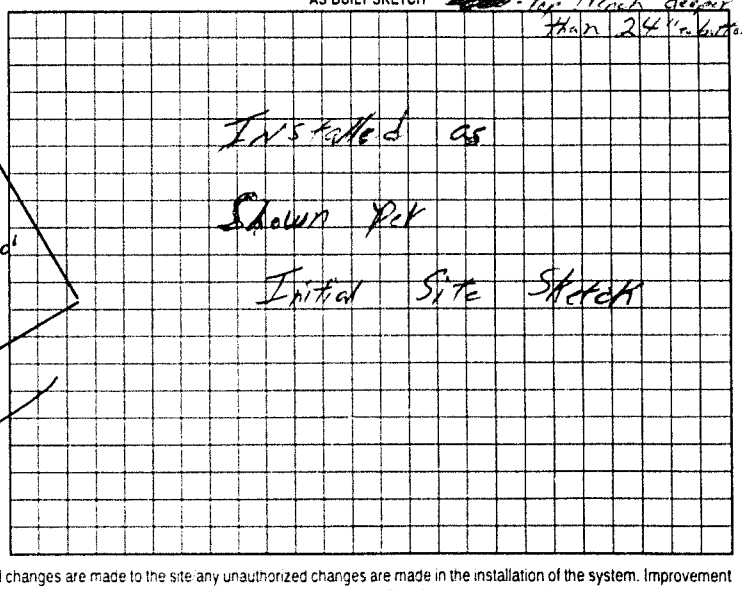

Permit can be suspended or revoked if any false information is supplied toward securing the permit any unauthorized changes are made to the site any unauthorized changes are made in the installation of the system. Improvement Permit with plat valid without expiration. Improvement Permit with site plan valid for sixty months. Authorization to Construct is valid for a period equal to that of Improvement Permit – not to exceed sixty months.

Signed: X James Paul Lintsey date 11-9-00 Installed by Wayne Orbison + Son

Improvement Permit by: E. C. Moore date 11-9-00 Operation Permit by: William Gyllotman date 6/17/01

Authorization to Construct by: E. C. Moore date 11-9-00 Existing System Inspection by date

HEALTH DEPT COPY: WHITE OWNER COPY (FINAL): YELLOW OWNER COPY (INITIAL): PINK