IREDELL COUNTY HEALTH DEPARTMENT

STATESVILLE 704-878-5305 MOORESVILLE 704-664-5281

IMPROVEMENT PERMIT / AUTHORIZATION TO CONSTRUCT / OPERATION PERMIT / EXISTING SYSTEM INSPECTION

PERMIT # Repair PIN # 4731-92-4324 DATE 5-27-09

OWNER or APPLICANT IRENE WAGNER PHONE: Business Home: 704-528-5274

OWNER or APPLICANT ADDRESS PO BOX 575 Troutman NC 28166

LOCATION / DIRECTIONS 21 SOUTH (R) WAGNER/ PORTH (L) EDA (R) LAKE CIRCLE LOT ON LEFT AT BOX # 619

SUBDIVISION JP Hollshouser BLOCK / SECTION LOT # 28 LOT AREA .46 DESIGN FLOW 360 L.T.A.R. EXISTING

Septic Tank 1000 Gallons: STB 760 Date 9-14-08 ☐ New System ☒ Repair ☐ Expansion System Type I (II) III IV V VI

Pump Tank Gallons: P T Date System Description: NEW 1000 GAL TANK

Pump Make Model Serial # Repair System Description:

Nitrification Field No Fields No Lines Linear Feet Maintenance Agreement Required ☐ YES ☒ NO

Trench Width Max. Trench Bottom Depth Gravel Depth ☒ GRAVITY ☐ PRESSURE


☒ Residence No. Bedrooms 3 ☐ Business No. Persons 1 ☐ Other No. Employees ☐ Slab ☐ Crawl Space ☐ Basement w/plumbing ☐ Basement w/o plumbing

Water Supply: ☒ Private ☐ Public ☐ Community


Comments / Conditions (1) MAIN TAIN 50' From well to TANK (2) Crush Fill Pump OLD TANK (3) Replace old tank with new tank (4) Keep New tank 5' off P/L & 5' OFF Foundation Pcl 77 LOT. PLAT Attached

Comments / Conditions This Permit Serves as Notice of Violation Must be repaired within 30 DAYS TANK LOCATED AS SHOWN DUE TO PROXIMITY of P.L.

INITIAL SITE SKETCH

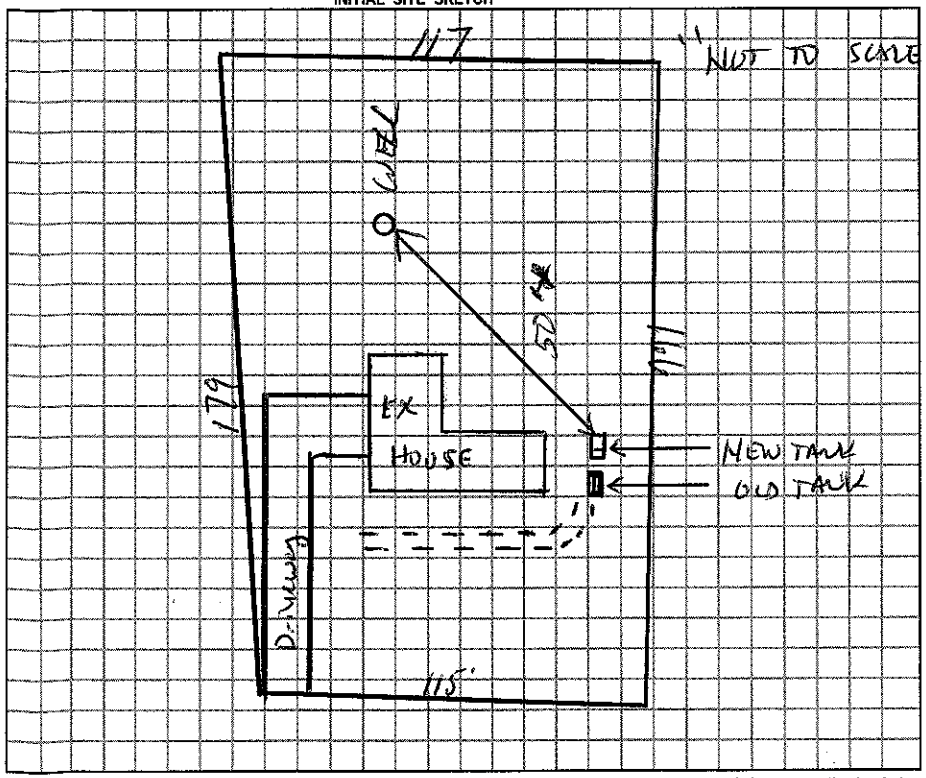

AS BUILT SKETCH

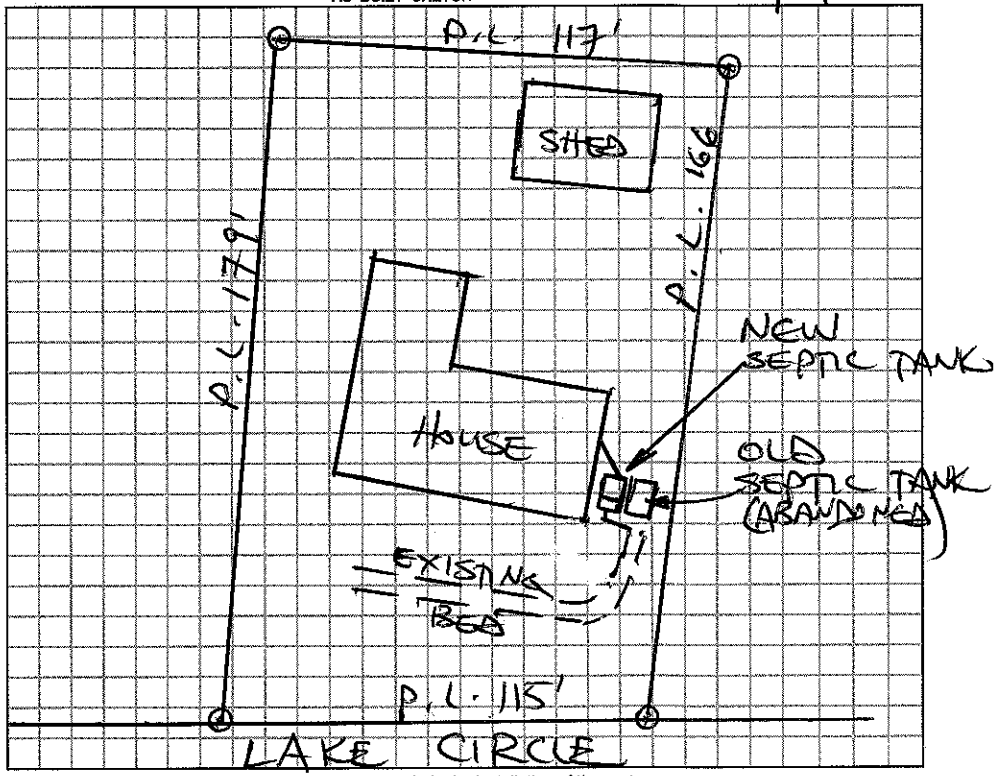

Permit can be suspended or revoked if any false information is supplied toward securing the permit / any unauthorized changes are made to the site / any unauthorized changes are made in the installation of the system.

☐ *IMPROVEMENT PERMIT w/ plat valid without expiration.* ☐ *IMPROVEMENT PERMIT w / site plan valid for 60 mos.* ☐ *AUTHORIZATION TO CONSTRUCT valid for period equal to IMPROVEMENT PERMIT-not to exceed 60 mo.*

Owner / Applicant Signature: Irene Wagner Date

Improvement Permit by: Date 5-27-09

Authorization to Construct by: Date 5-27-09

YOU SHOULD CONTACT A LOCATOR SERVICE PRIOR TO ANY EXCAVATION.

Installed by: A-1 BACKHOE

Operation Permit by: STEVE HEDRICK Date: 6-12-09

Existing System Inspected by: Date:

WHITE COPY Environmental Health YELLOW COPY (Final) Owner / Applicant PINK COPY (Initial) Owner / Applicant