IREDELL COUNTY HEALTH DEPARTMENT

Statesville Phone TR 3-7271 — Mooresville Phone NO 3-1271

PERMIT TO INSTALL SEPTIC TANK

Permit NO. _____ Permit Date OCT 8 195 8

Owner TROUTMAN DRUG STORE Address TROUTMAN, N.C.

Installed By OSTWALT Address _____


Location of Property IN TROUTMAN - LARGE BRICK

Tank		Capacity		Length of Lines		Fixtures	
Block	(X)	800	( )	150'	( )	No. of Baths	( )
Precast	( )	900	( )	175'	( )	Dishwasher	( )
BLOCK		1000	( )	200'	( )	Garbage Grdr.	( )
		1100	( )	225'	( )	Auto-Washer	( )
		1200	( )	250'	( )	Other	
		Other 1430		Other 505'			

NOTIFY HEALTH DEPARTMENT AT LEAST EIGHT HOURS BEFORE TANK IS TO BE INSPECTED.

Final Inspection OCT 8 1958 Approved (X) Disapproved ( )

Remarks DESIGNED BY - J. S. AMEEN S.B. OF H.

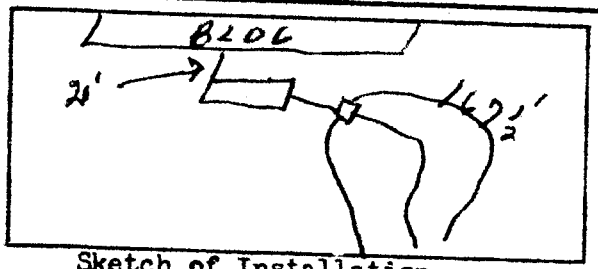

Sketch of Installation

Rufus A Howard

Sanitarian