IREDELL COUNTY HEALTH DEPARTMENT

Statesville Phone TR 3-7271 Mooresville Phone NO 3-1271

PERMIT TO INSTALL SEPTIC TANK

Permit NO._____ Permit Date Oct 21 1958

Owner Holy Trinity Luth. Church Address Troutman

Installed By Ostwalt Address _____


Location of Property Troutman

Tank		Capacity		Length of Lines		Fixtures	
Block	( )	800	( )	150'	(✓)	No. of Baths	(1)
Precast	(✓)	900	(✓)	175'	( )	Dishwasher	( )
		1000	( )	200'	( )	Garbage Grdr.	( )
		1100	( )	225'	( )	Auto-Washer	( )
		1200	( )	250'	( )	Other	
		Other		Other			

NOTIFY HEALTH DEPARTMENT AT LEAST EIGHT HOURS BEFORE TANK IS TO BE INSPECTED.

Final Inspection Oct 21 1958 Approved (✓) Disapproved ( )

Remarks _____

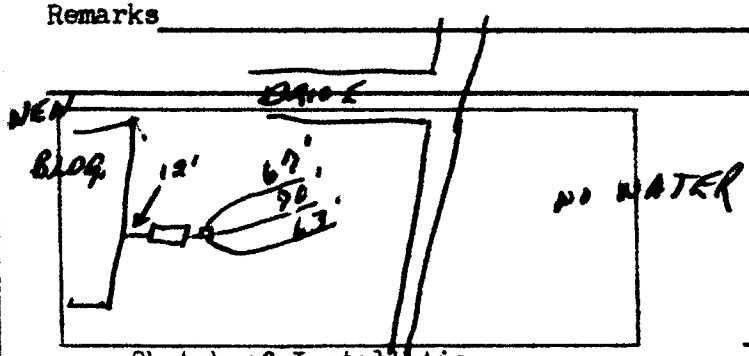

Sketch of Installation

Raford A. Thomas

Sanitarian