IREDELL COUNTY HEALTH DEPARTMENT

Statesville Phone TR 3-7271 Mooresville Phone No. 664-5281

PERMIT TO INSTALL SEPTIC TANK

Permit No. [illegible] Permit Date 9-18 1973

Owner Jimmy Dagenhart Address Statesville N.C.

Installed By Lackey Bro Address Stony Point N.C.


Location of Property South Wood Development off of old Mt Pl. House on L. in Curve at Stream.

Tank		Capacity		Length of Lines		Fixtures	
Block	( )	~~1000~~ 800	(✓)	225'	( )	No. of Baths	(3½)
Precast	( )	1250	(✓)	250'	( )	Dishwasher	( )
		1500	( )	Other 270+120		Garbage Grdr.	( ) O.K
		Other				Other	

NOTIFY HEALTH DEPARTMENT AT LEAST EIGHT HOURS BEFORE TANK IS TO BE INSPECTED.

Final Inspection 9-18 1973 Approved (✓) Disapproved ( )

Remarks Well 100'+ from lines

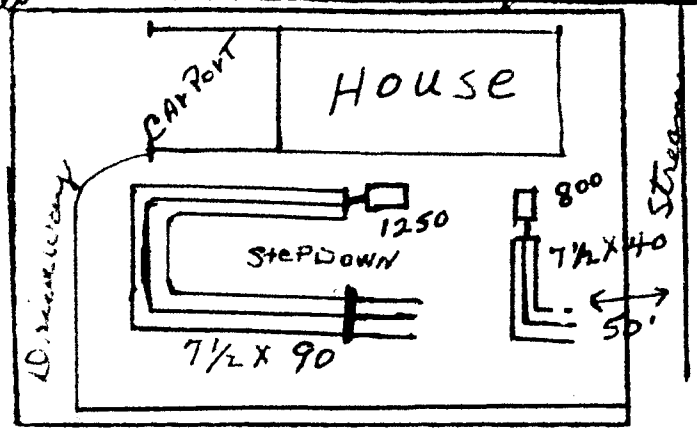

Sketch of Installation (over)

Water from house should be diverted away from lines

E. A. Stevenson

Sanitarian