IREDELL COUNTY HEALTH DEPARTMENT - *ENVIRONMENTAL HEALTH* ☐ STATESVILLE OFFICE 704-878-5305 ☐ MOORESVILLE OFFICE 704-664-5281

IMPROVEMENT PERMIT / AUTHORIZATION TO CONSTRUCT / OPERATION PERMIT / EXISTING SYSTEM INSPECTION

PERMIT # Repair PIN # 4732-02-5929 DATE 28 February 11

OWNER Eric Hylton APPLICANT:

SITE ADDRESS 104 Pilgrim Cir Statesville PHONE: Home/Cell # Business #

SITE DIRECTIONS Old Nat. Rd. Turn Southwood TR Pilgrim Circle on Rt. OWNER / APPLICANT ADDRESS

SUBDIVISION SOUTHWOOD BLOCK / SECTION II LOT # 35 LOT AREA 0.5 Ac DESIGN FLOW 360 L.T.A.R. 0.3 (EX)

Septic Tank 1000g Gallons: STB Date

Pump Tank Gallons: P T Date

Pump Make Model Serial #

No. Nitrification Fields: NA No. Lines NA Linear Feet NA

Trench Width NA Max. Trench Bottom Depth NA Gravel Depth NA

☐ New System ☑ Repair ☐ Expansion System Type I (II) III IV V VI

System Description:

Repair System Description: Replace Septic Tank

Maintenance Agreement Required ☐ YES ☑ NO

☑ GRAVITY ☐ PRESSURE

☑ Residence ☐ Business ☐ Other ☐ Slab ☐ Basement w/plumbing

No. Bedrooms 3 No. Persons No. Employees ☐ Crawl Space


Water Supply: ☑ Private ☐ Public ☐ Community

☑ Basement w/o plumbing


Comments / Conditions

* Replace Septic tank / Keep 50' From well / Property Abandon old Septic Tank.

INITIAL SITE SKETCH

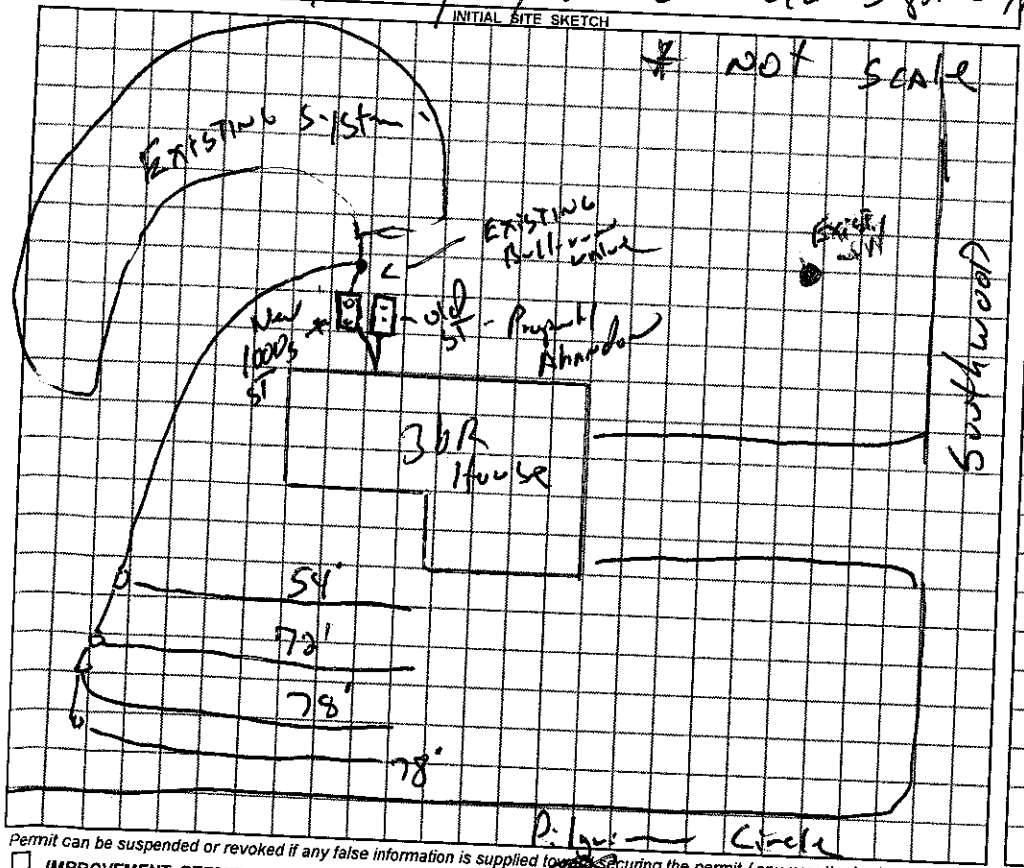

AS BUILT SKETCH

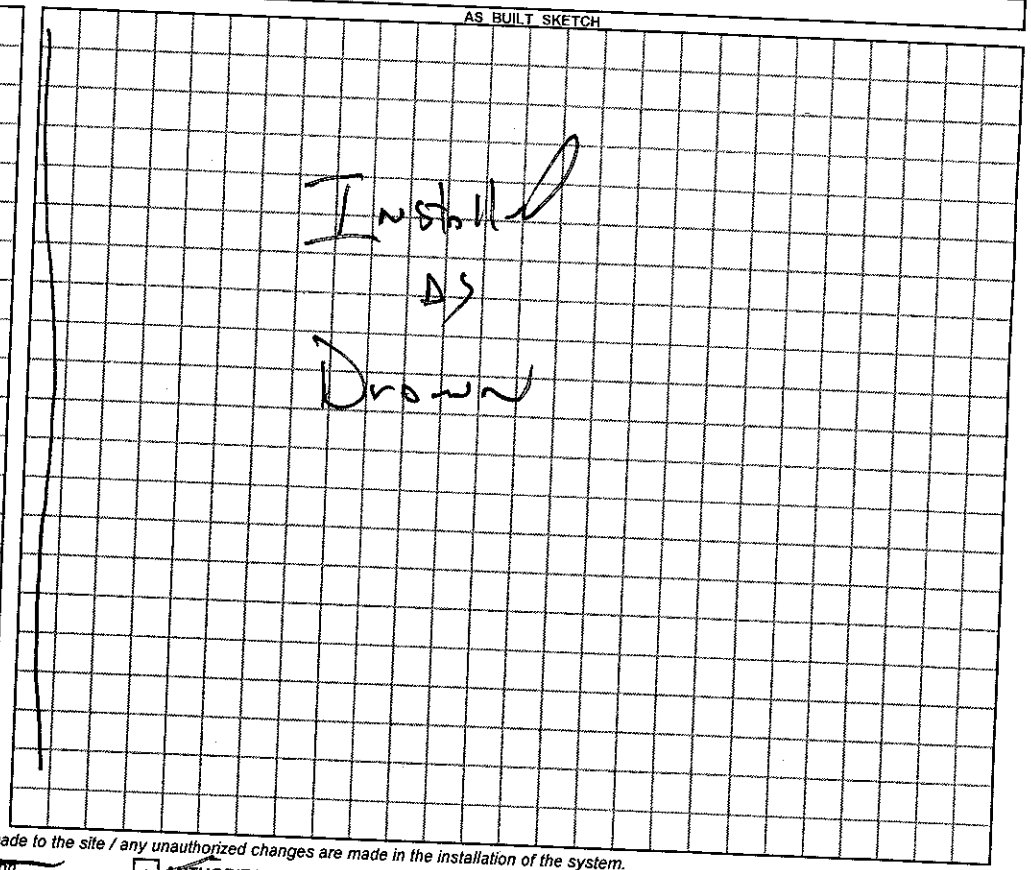

Permit can be suspended or revoked if any false information is supplied for securing the permit / any unauthorized changes are made to the site / any unauthorized changes are made in the installation of the system.

☐ ***IMPROVEMENT PERMIT*** with plat valid without expiration. ☑ ***IMPROVEMENT PERMIT*** with plat valid without expiration. ☑ ***AUTHORIZATION TO CONSTRUCT*** valid for period equal to IMPROVEMENT PERMIT--not to exceed 60 mo.

Owner / Applicant Signature: Dennis Gallehan Date

IMPROVEMENT PERMIT by: REHS Date

AUTHORIZATION TO CONSTRUCT by: REHS Date 24 Feb. 11

YOU SHOULD CONTACT A LOCATOR SERVICE PRIOR TO ANY EXCAVATION

Installed by: A&L Backhoe

OPERATION PERMIT by: REHS Date 27 April 11

Existing System Inspected by: REHS Date

White Copy -- Environmental Health YELLOW COPY (Final) Owner / Applicant PINK COPY (Initial) Owner / Applicant