IREDELL COUNTY HEALTH DEPARTMENT

STATESVILLE 704-878-5305 MOORESVILLE 704-664-5281

IMPROVEMENT PERMIT / AUTHORIZATION TO CONSTRUCT / OPERATION PERMIT / EXISTING SYSTEM INSPECTION

PERMIT# 72859 PIN# 4732 03 3835 DATE 5-26-98

OWNER OR CONTRACTOR Susan L. Stinson PHONE: Business Home

ADDRESS 519 Old mt. Rd

LOCATION 213 TR OMR Troutman Wallace sp Rd on left, behind No. 519

SUBDIVISION BLOCK / SECTION LOT LOT AREA 12 acres SITE CLASS: PS DESIGN FLOW 240 T.A.R. 13

Septic Tank: 1000 Gallons; STB 1012 Date ~~PB~~ 4-2-98
Pump Tank: Gallons; PT Date
Pump Make: Model Serial No.
Nitrification Field: No Fields 1 Square Feet 810 Linear Feet 270
No Lines 2 Trench Width 36" Max Trench Bottom Depth 30" Gravel Depth 12"

☑ New System ☐ Repair System Type: ☐ I ☐ II ☐ III, IV, V, VI
System Description: Conv. Gravity
Repair System Description:
Maintenance Agreement Required: ☐ Yes ☑ No


☐ House/Mod. Home No. Bedrooms 2
☐ Mobile Home No. Bathrooms 2
☐ Business No. Employees
☐ Other
☐ Slab ☑ Crawl Space ☐ Basement w/plumbing ☐ Basement wo/plumbing

Water Supply: ☑ Individual ☐ Public ☐ Community


Comments/Conditions: PL

Comments/Conditions:

INITIAL SITE SKETCH

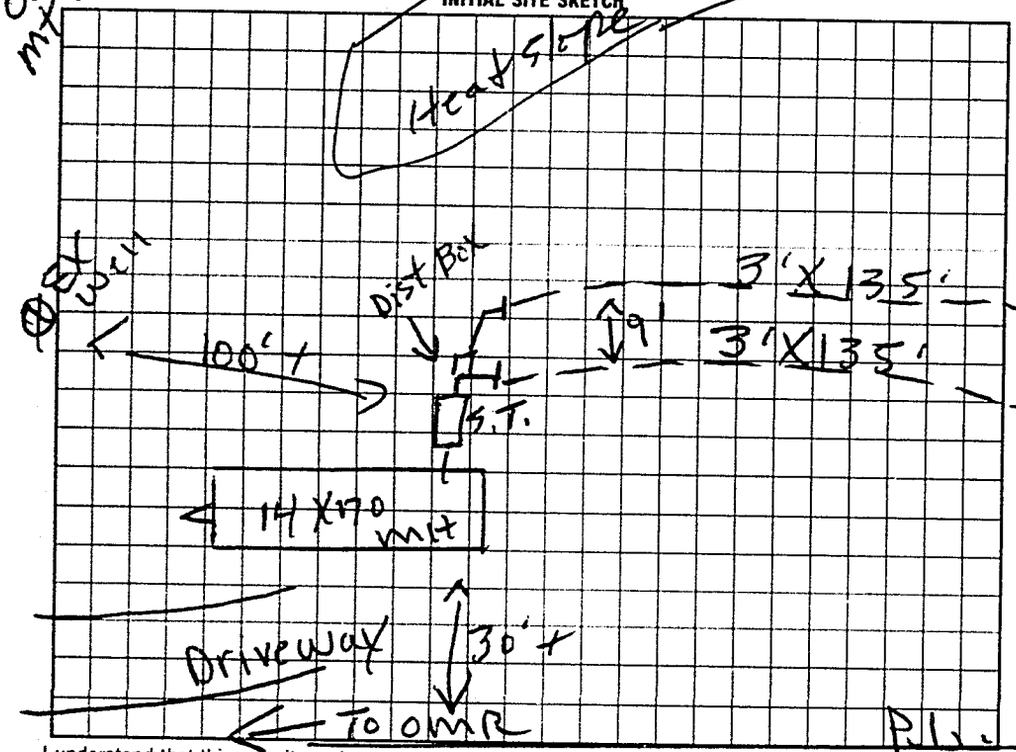

AS BUILT SKETCH

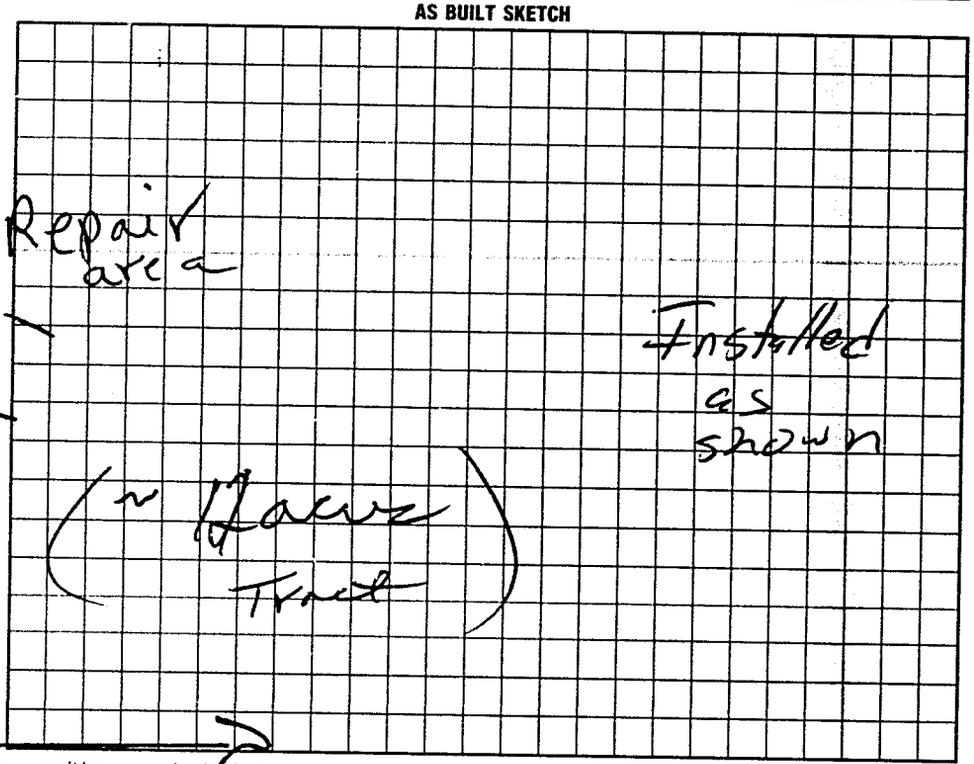

I understand that this permit can be suspended or revoked if any false information is supplied toward securing the permit/any unauthorized changes are made to the site/any unauthorized changes are made in the installation of the system. Improvement Permit with plat valid without expiration. Improvement Permit with site plan valid for sixty months. Authorization to Construct is valid for a period equal to that of Improvement Permit – not to exceed sixty months.

Signed: X Christine A Stinson date 5-26-98 Installed by: Rick Shook

Improvement Permit by: C. Moore date 5-26-98 Operation Permit by: [illegible] C.O.H.S. date 6-15-98

Authorization to Construct by: C. Moore date 5-26-98 Existing System Inspection by: date

HEALTH DEPT. COPY (WHITE) INSPECTION COPY (FINAL) GREEN OWNER COPY (FINAL) YELLOW INSPECTION COPY (INITIAL) PINK OWNER COPY (INITIAL) GOLD

85008