IREDELL COUNTY HEALTH DEPARTMENT

STATESVILLE 704-878-5305 MOORESVILLE 704-664-5281

IMPROVEMENT PERMIT / AUTHORIZATION TO CONSTRUCT / OPERATION PERMIT / EXISTING SYSTEM INSPECTION

PERMIT# 75931 PIN# 4732 04 3948 DATE 8-27-98

OWNER OR CONTRACTOR Jurgen Wokatsch PHONE: Business _____ Home 528-4405

ADDRESS 504 Old mtn Rd

LOCATION 215 TR OMR on Rt before Wallace Sp Rd

SUBDIVISION Kyles 50 BLOCK / SECTION _____ LOT 19 LOT AREA 100 X 260' SITE CLASS. PS DESIGN FLOW 360 L.T.A.R. .33

Septic Tank: 1000 Gallons; STB 160 Date 8-7-98

Pump Tank: _____ Gallons: PT _____ Date _____

Pump Make: _____ Model _____ Serial No. _____

Nitrification Field: No Fields 1 Square Feet 1050 Linear Feet 350

No Lines 5 Trench Width 36" Max Trench Bottom Depth 36" Gravel Depth 12"

☑ New System ☐ Repair System Type: I, II, III, IV, V, VI

System Description: Conv. Gravity

Repair System Description: " "

Maintenance Agreement Required: ☐ Yes ☑ No

☐ House/Mod. Home No. Bedrooms 3

☑ Mobile Home No. Bathrooms 2

☐ Business No. Employees ____

☐ Other _____


☐ Slab ☑ Crawl Space ☐ Basement w/plumbing ☐ Basement wo/plumbing

Water Supply: ☑ Individual ☐ Public ☐ Community


Comments:/Conditions:

Comments:/Conditions:

INITIAL SITE SKETCH

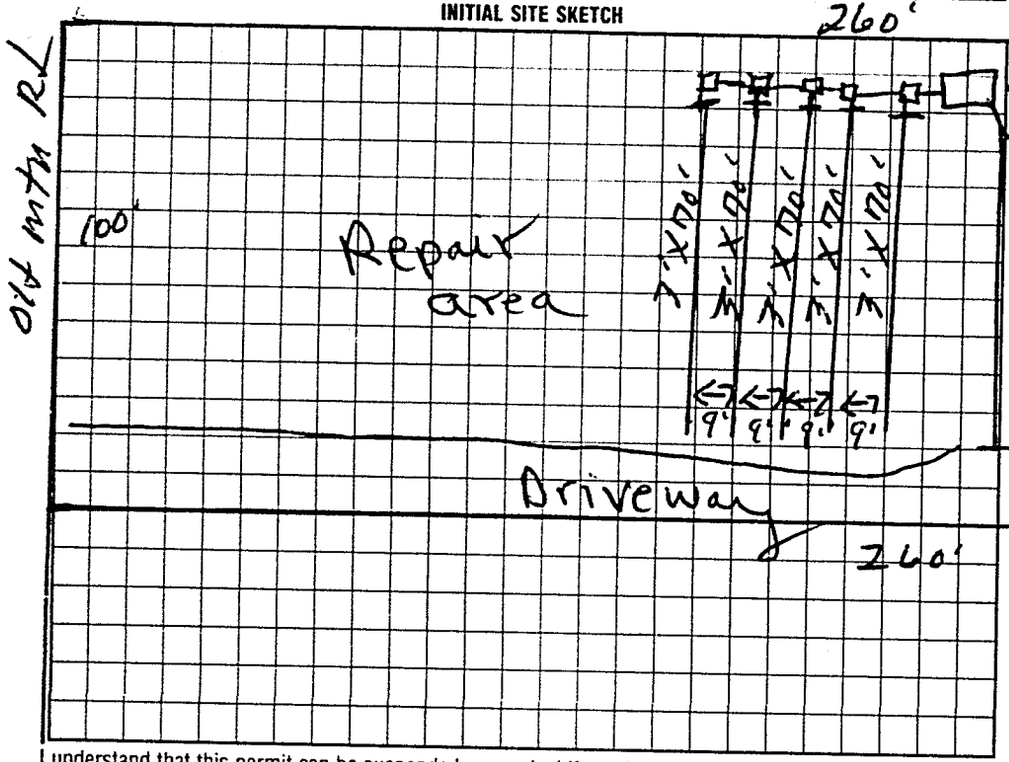

AS BUILT SKETCH

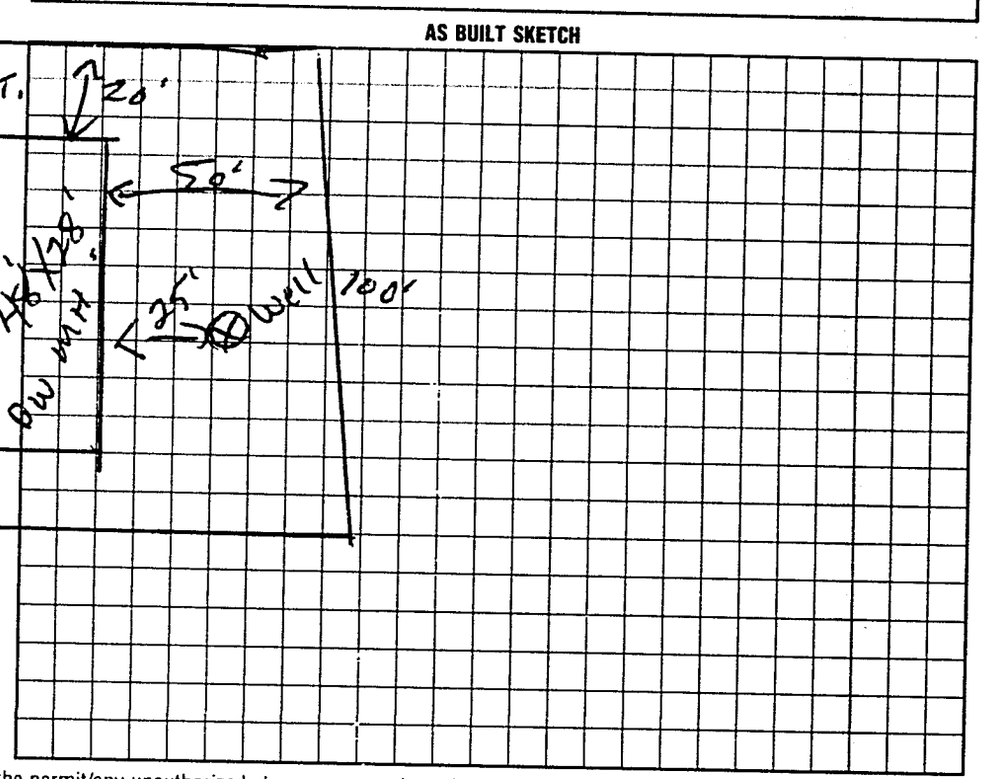

I understand that this permit can be suspended or revoked if any false information is supplied toward securing the permit/any unauthorized changes are made to the site/any unauthorized changes are made in the installation of the system. Improvement Permit with plat valid without expiration. Improvement Permit with site plan valid for sixty months. Authorization to Construct is valid for a period equal to that of Improvement Permit – not to exceed sixty months.

Signed: Jurgen Wokatsch date 8-27-98 Installed by: SHANE JARRETT

Improvement Permit by: E. C. Moore date 8-27-98 Operation Permit by: STEVE HEDRICK date 9-11-98

Authorization to Construct by: E. C. Moore date 8-27-98 Existing System Inspection by: _____ date _____

HEALTH DEPT COPY WHITE INSPECTION COPY (FINAL) GREEN OWNER COPY (FINAL) YELLOW INSPECTION COPY (INITIAL) PINK OWNER COPY (INITIAL) GOLD