IREDELL COUNTY HEALTH DEPARTMENT

Statesville Phone TR 3-7271 Mooresville Phone NO 3-1271

PERMIT TO INSTALL SEPTIC TANK

Permit No. 276 Permit Date _____ 19__

Owner Gene Trantman Address _____

Installed By Dent Jim Lackey Address _____


Location of Property Trantmans Development Third new house on left. 2 story. (Southwood) #29 Lot.

Tank		Capacity		Length of Lines		Fixtures	
Block	( )	1000	( )	225'	( )	No. of Baths	(2)
Precast	(✓)	1250	( )	250'	( )	Dishwasher	( )
		1500	( )	Other _____		Garbage Grdr.	( )
		Other _____				Other _____	

NOTIFY HEALTH DEPARTMENT AT LEAST EIGHT HOURS BEFORE TANK IS TO BE INSPECTED.

Final Inspection 10-20-1971 Approved (✓) Disapproved ( )

Remarks _____

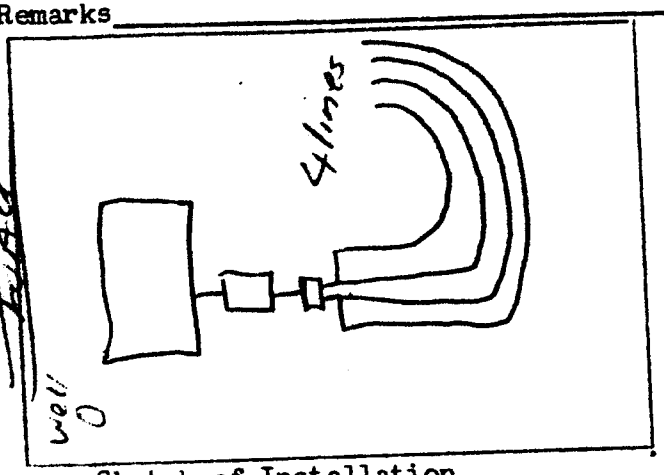

Sketch of Installation

Sanitarian