IREDELL COUNTY HEALTH DEPARTMENT

STATESVILLE 704-878-5305 MOORESVILLE 704-664-5281

IMPROVEMENT PERMIT / AUTHORIZATION TO CONSTRUCT / OPERATION PERMIT / EXISTING SYSTEM INSPECTION

PERMIT# Repair PIN# DATE 1-23-99

OWNER OR CONTRACTOR Clyde M. Williams PHONE: Business Home 528-6174

ADDRESS 873 Walnut Springs Rd Statesville

LOCATION 215 TR OMR OTL Wallace Spring

SUBDIVISION BLOCK / SECTION LOT 0 LOT AREA SITE CLASS. Pls DESIGN FLOW 360 L.T.A.R.

Septic Tank: 1000 Ex Gallons; STB Date

Pump Tank: Gallons; PT Date

Pump Make: Model Serial No.

Nitrification Field: No Fields 1 Square Feet 360 Linear Feet 120

No Lines 1 Trench Width 36in Max Trench Bottom Depth 36in Gravel Depth 18in

☐ New System ☒ Repair System Type: I II III IV V VI

System Description:

Repair System Description: Grant Conventional

Maintenance Agreement Required: ☐ Yes ☒ No

☒ House/Mod. Home No. Bedrooms 3

☐ Mobile Home No. Bathrooms 1½

☐ Business No. Employees

☐ Other


☐ Slab ☒ Crawl Space ☐ Basement w/plumbing ☐ Basement wo/plumbing

Water Supply: ☒ Individual ☐ Public ☐ Community


Comments/Conditions: This permit serves as Notice of Violation Installed 3 lines @ 40ft with 18in stone keep 50 feet from well, keep 5Ft from property line

Comments/Conditions:

INITIAL SITE SKETCH

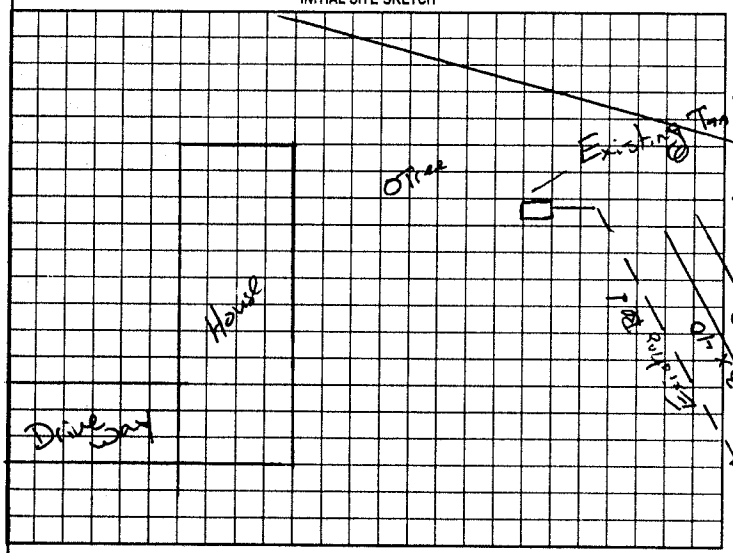

AS BUILT SKETCH

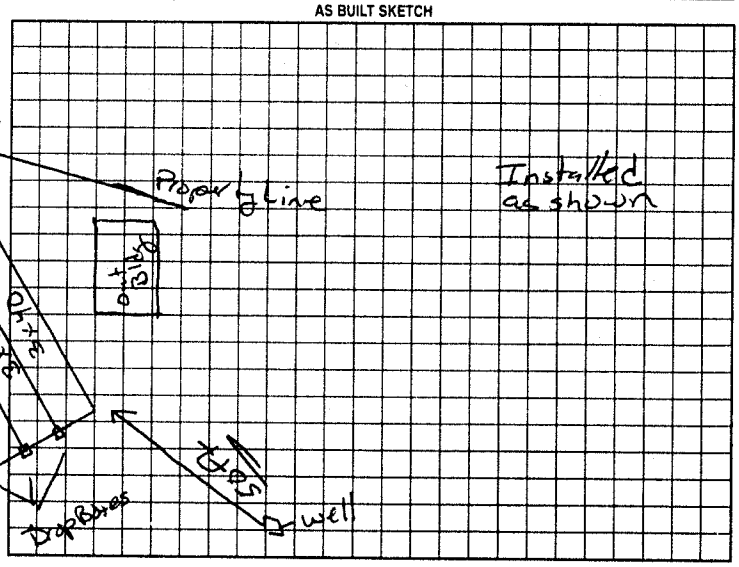

Permit can be suspended or revoked if any false information is supplied toward securing the permit/any unauthorized changes are made to the site/any unauthorized changes are made in the installation of the system. Improvement Permit with plat valid without expiration. Improvement Permit with site plan valid for sixty months. Authorization to Construct is valid for a period equal to that of Improvement Permit – not to exceed sixty months.

Signed: Clyde M. Williams date

Improvement Permit by: Mary C Ott RS date 1-23-99

Authorization to Construct by: Mary C. Ott RS date 1-23-99

Installed by: Wes Lytton

Operation Permit by: Mary C Ott date 6-18-99

Existing System Inspection by: date

HEALTH DEPT. COPY WHITE OWNER COPY (FINAL) YELLOW OWNER COPY (INITIAL) PINK