Site Address: 144 Autumn Mist Rd., Stat.

IREDELL COUNTY HEALTH DEPARTMENT

STATESVILLE 704-878-5305 MOORESVILLE 704-664-5281

IMPROVEMENT PERMIT / AUTHORIZATION TO CONSTRUCT / OPERATION PERMIT / EXISTING SYSTEM INSPECTION

PERMIT# 15079S 21694D PIN# 4732-64-0066.050 4732055554 (5554) DATE 6/30/08

OWNER OR APPLICANT Autumn Rock, LLC PHONE: Business 704-996-2277 Home

ADDRESS 323 WALNUT ST Statesville NC 28677

LOCATION 21 SOUTH (R) ONR (R) WALLACE SPRINGS (R) AUTUMN MIST LOT ON RT

SUBDIVISION Autumn Brook BLOCK / SECTION 1 LOT 50 LOT AREA 1.974 SITE CLASS. PS DESIGN FLOW 440D L.T.A.R. .3

Septic Tank: 1000 Gallons; STB 2071 Date 10/00

Pump Tank: _____ Gallons; PT _____ Date _____

Pump Make: _____ Model _____ Serial No. _____

Nitrification Field: No Fields 1 Square Feet 600/660 Linear Feet 400'

No Lines 4 x 100' Trench Width 36" Max Trench Bottom Depth 36" Gravel Depth N/A

☒ New System ☐ Repair ☐ Expansion System Type: I (II) III IV V VI

System Description: GRAVITY .25% REDUCTION

Repair System Description: PUMP 25% REDUCTION

Maintenance Agreement Required: ☐ Yes ☒ No

☒ House/Mod. Home ☐ Mobile Home ☐ Business ☐ Other

No. Bedrooms 4 No. Persons 8 No. Employees ____

Water Supply: ☐ Individual ☒ Public ☐ Community

☐ Gravity ☐ Pressure ☐ Slab ☒ Crawl Space ☐ Basement w/plumbing ☐ Basement wo/plumbing

Comments:/Conditions:

Comments:/Conditions:

INITIAL SITE SKETCH

SEE ATTACHED SYSTEM DESIGN BY POLARIS SOIL & ENVIRONMENTAL

AS BUILT SKETCH

Permit can be suspended or revoked if any false information is supplied toward securing the permit/any unauthorized changes are made to the site/any unauthorized changes are made in the installation of the system. Improvement Permit with plat valid without expiration ☐ Improvement Permit with site plan valid for sixty months ☒ Authorization to Construct is valid for a period equal to that of Improvement Permit – not to exceed sixty months.

Signed: Autumn Brook LLC date 9-5-08

Improvement Permit by: _____ date 6/30/08


Authorization to Construct by: _____ date 08/29/16

Installed by: Specialty Septic

Operation Permit by: W Sparks date 9/30/16

Existing System Inspection by: _____ date _____

HEALTH DEPT. COPY: WHITE OWNER COPY (FINAL): YELLOW OWNER COPY (INITIAL): PINK

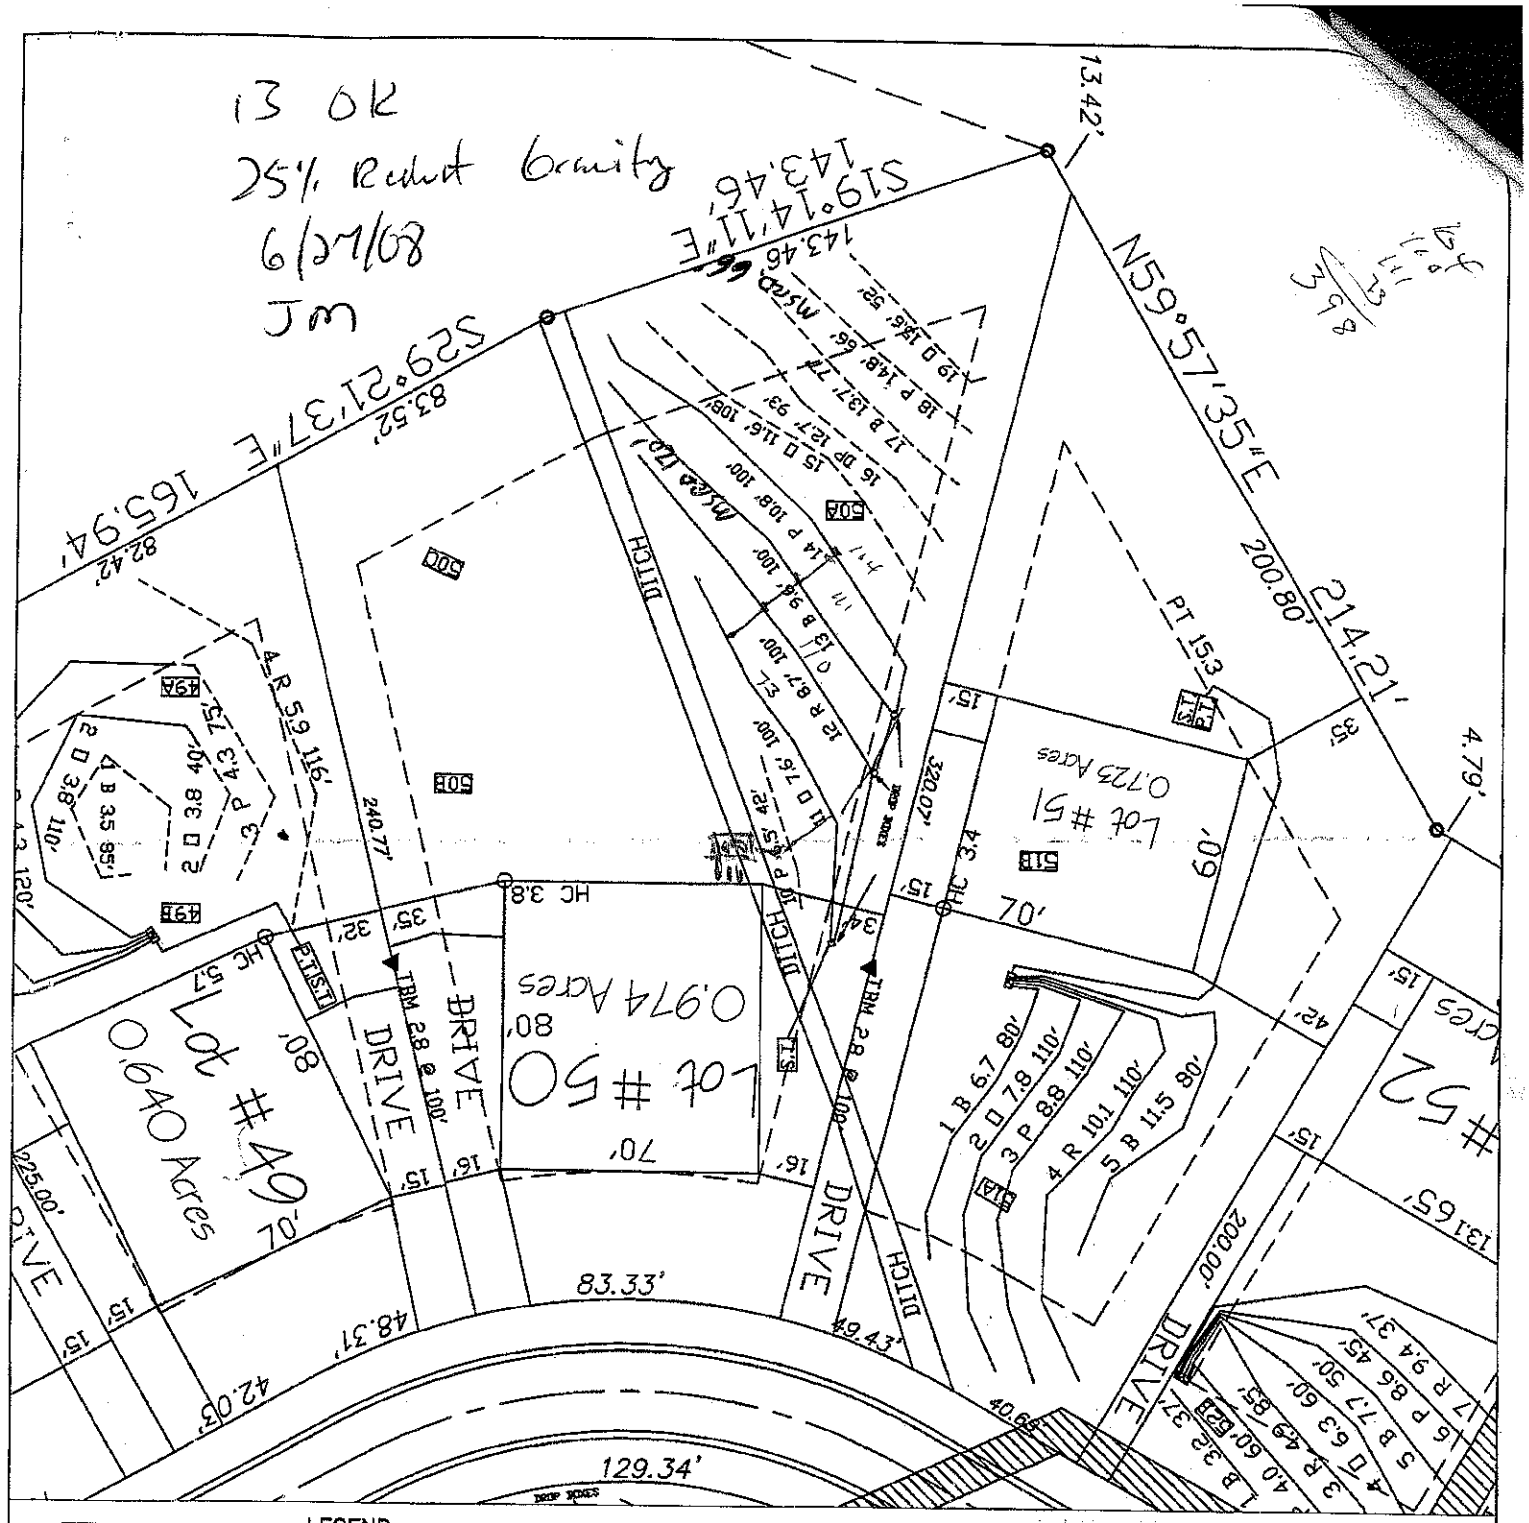

FOR PRELIMINARY PLANNING PURPOSES ONLY. ALL LOTS WILL REQUIRE FINAL APPROVAL BY THE COUNTY HEALTH DEPARTMENT ON A LOT BY LOT BASIS. THIS MAP SHOULD BY USED AS A GENERAL GUIDE, SOME ADJUSTMENTS WILL BE NECESSARY IN THE FIELD DUE TO SOIL VARIABILITY AND COMPLEX TOPOGRAPHIC FEATURES. THIS MAP ONLY REFLECTS EXISTING SOIL SUITABILITY FOR ON-SITE SEPTIC TANK SYSTEMS.

ROLLANS SOIL & ENVIRONMENTAL SERVICES

470 N. BROAD ST., SUITE D
MOORESVILLE, NC 28115
PHONE/FAX: (704) 658-1723

ASHLEY ROLLANS, NC LICENSED SOIL SCIENTIST
MOBILE: (704) 746-5046
EMAIL: ROLLANS@WINDSTREAM.NET

MAP TITLE:	PRELIMINARY SOIL EVALUATION
PROJECT NAME:	THE JOHNSON GROUP / AUTUMN BROOK
LOCATION/DATE:	WALLACE SPRINGS ROAD REDELL COUNTY, NORTH CAROLINA JUNE 2008
JOB # :	01-1439
FILE:	C:\JOBS\01-1439
PROJECT MGR.:	A.L.P
FIELD WORK:	A.L.P
DRAWN BY:	A.L.P