IREDELL COUNTY HEALTH DEPARTMENT

STATESVILLE 704-878-5305 MOORESVILLE 704-664-5281

IMPROVEMENT PERMIT / AUTHORIZATION TO CONSTRUCT / OPERATION PERMIT / EXISTING SYSTEM INSPECTION

PERMIT# 93332 PIN# 4732 06 2139 DATE 12/18/00

OWNER OR CONTRACTOR Keith Miller PHONE: Business 838-0461 Home

ADDRESS 117 Airport Rd Statesville NC 28677

LOCATION 215 R Old Mtn., L Wallace Springs, R Chris on Rt

SUBDIVISION Williams Farm BLOCK / SECTION LOT 2 LOT AREA .51 AC SITE CLASS PS DESIGN FLOW 360 L.T.A.R. 0.55

Septic Tank: 1000 Gallons: STB 760 Date 7/30/00
Pump Tank: Gallons: PT Date
Pump Make: Model Serial No
Nitrification Field: No Fields 1 Square Feet 1029 Linear Feet 344
No Lines 4 @ 86' Trench Width 36" Max Trench Bottom Depth 36" Gravel Depth 12"

☒ New System ☐ Repair System Type: I (II) III. IV. V. VI
System Description: Grav. Sy Evaluation
Repair System Description: Gravity PPTS
Maintenance Agreement Required: ☐ Yes ☒ No


☒ House/Mod. Home No. Bedrooms 3
☐ Mobile Home No. Bathrooms 2
☐ Business No. Employees
☐ Other
☐ Slab ☒ Crawl Space ☐ Basement w/plumbing ☐ Basement wo/plumbing

Water Supply: ☒ Individual ☐ Public ☐ Community


Comments/Conditions:

Comments/Conditions: ① NO CUTTING OR FILLING OVER DRAINFIELD/REPAIR AREA ② KEEP ALL DRAINS AWAY FROM DRAINFIELD/REPAIR AREAS ③ PUMP SEPTIC TANK EVERY 3-5 YRS.

INITIAL SITE SKETCH

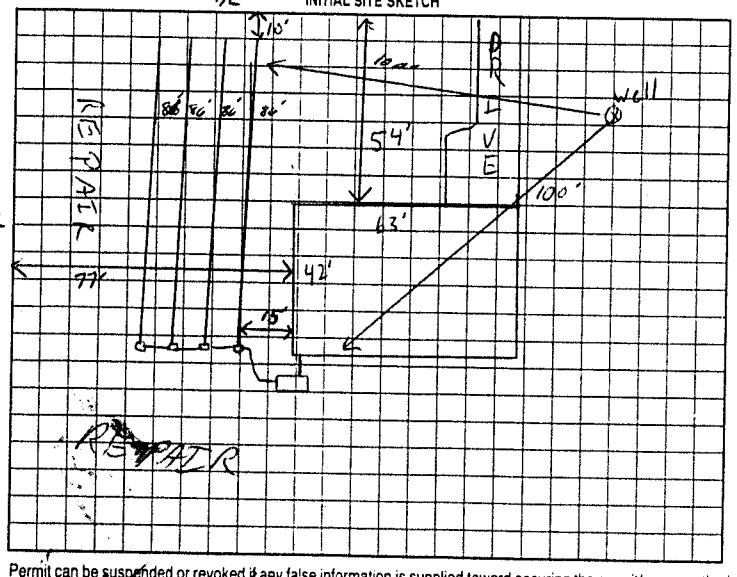

AS BUILT SKETCH

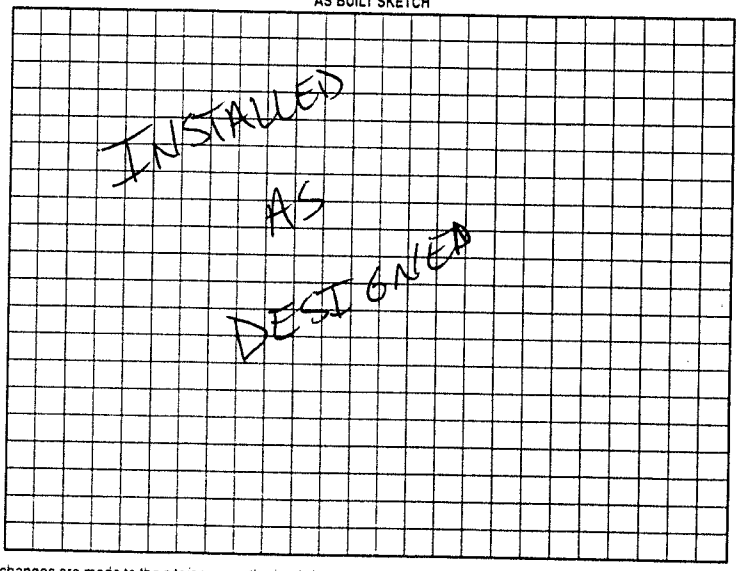

Permit can be suspended or revoked if any false information is supplied toward securing the permit/any unauthorized changes are made to the site/any unauthorized changes are made in the installation of the system. Improvement Permit with plot valid without expiration. Improvement Permit with site plan valid for sixty months. Authorization to Construct is valid for a period equal to that of Improvement Permit – not to exceed sixty months.

Signed: Dick Miller date 1/3/01 Installed by: RICK MILLER

Improvement Permit by: RSE date 12/18/00 Operation Permit by: Jerry Shinn date 3/19/01

Authorization to Construct by: RSE date 12/18/00 Existing System Inspection by: date

HEALTH DEPT COPY WHITE OWNER COPY (FINAL): YELLOW OWNER COPY (INITIAL): PINK