Site Address: 113 Autumn Mist Rd - Stat.

IREDELL COUNTY HEALTH DEPARTMENT

STATESVILLE 704-878-5305 MOORESVILLE 704-664-5281

IMPROVEMENT PERMIT / AUTHORIZATION TO CONSTRUCT / OPERATION PERMIT / EXISTING SYSTEM INSPECTION

PERMIT# ~~150744~~ 216938 PIN# ~~4732467040.000~~ 4732067274 DATE 7-3-08

OWNER OR APPLICANT Autumn Brook LLC PHONE: Business 704-996-2277 Home

ADDRESS 323 Walnut St Statesville NC 28677

LOCATION Hwy 21S TR old Mtn Rd TR Wallace Springs TR Autumn Mist on right at corner Sienna Chase

SUBDIVISION Autumn Brook BLOCK / SECTION 1 LOT 28 LOT AREA .48 AC SITE CLASS. PS DESIGN FLOW 480gpd L.T.A.R. .3 gpd/ft²

Septic Tank: 1000 Gallons; STB 794 Date 10/4/16

Pump Tank: 1000 Gallons; PT 283 Date 9/27/16

Pump Make: Orenco Model PF-56051 Serial No.

Nitrification Field: No Fields 1 Square Feet Linear Feet 280

No Lines 4@70' Trench Width 24" Max Trench Bottom Depth 36"

☒ New System ☐ Repair ☐ Expansion System Type: I II III (IV) V VI

System Description: LP PPBPS

Repair System Description: LP PPBPS

Maintenance Agreement Required: ☒ Yes ☐ No

☒ House/Mod. Home No. Bedrooms 4

☐ Mobile Home No. Persons

☐ Business No. Employees

☐ Other

Water Supply: ☐ Individual ☒ Public ☐ Community

Gravel Depth NA ☐ Gravity ☒ Pressure ☐ Slab ☒ Crawl Space ☐ Basement w/plumbing ☐ Basement wo/plumbing

Comments:/Conditions:

Do not cut for house. Backfill for positive drainage

In-line pump filter required

INITIAL SITE SKETCH

See Plan from Rollins Soil & Environmental Services

Comments:/Conditions: 11/8/16 Tanks & lines Checked by WS

AS BUILT SKETCH

	Date	Initials
Drain Lines Checked	11/8/16	WS
Tanks Checked	1	WS
Pressure Manifold or Valve Box Checked	1	WS
Pressure Head Set	3/2/17	MD
Electrical Checked	/	/
Floats Set	/	/
Alarm Checked	/	/
Maintenance Contract Y/N	0	
Comments:		

Permit can be suspended or revoked if any false information is supplied toward securing the permit/any unauthorized changes are made to the site/any unauthorized changes are made in the installation of the system. Improvement Permit with plat valid without expiration ☐ Improvement Permit with site plan valid for sixty months ☒ Authorization to Construct is valid for a period equal to that of Improvement Permit – not to exceed sixty months.

Signed: Mgr. Autumn Brook LLC date 7-15-08

Improvement Permit by: date 7-3-08


Authorization to Construct by: date 03/29/16

Installed by: Specialty Septic

Operation Permit by: Marion Watson date 3/2/17

Existing System Inspection by: date

HEALTH DEPT. COPY: WHITE OWNER COPY (FINAL): YELLOW OWNER COPY (INITIAL): PINK

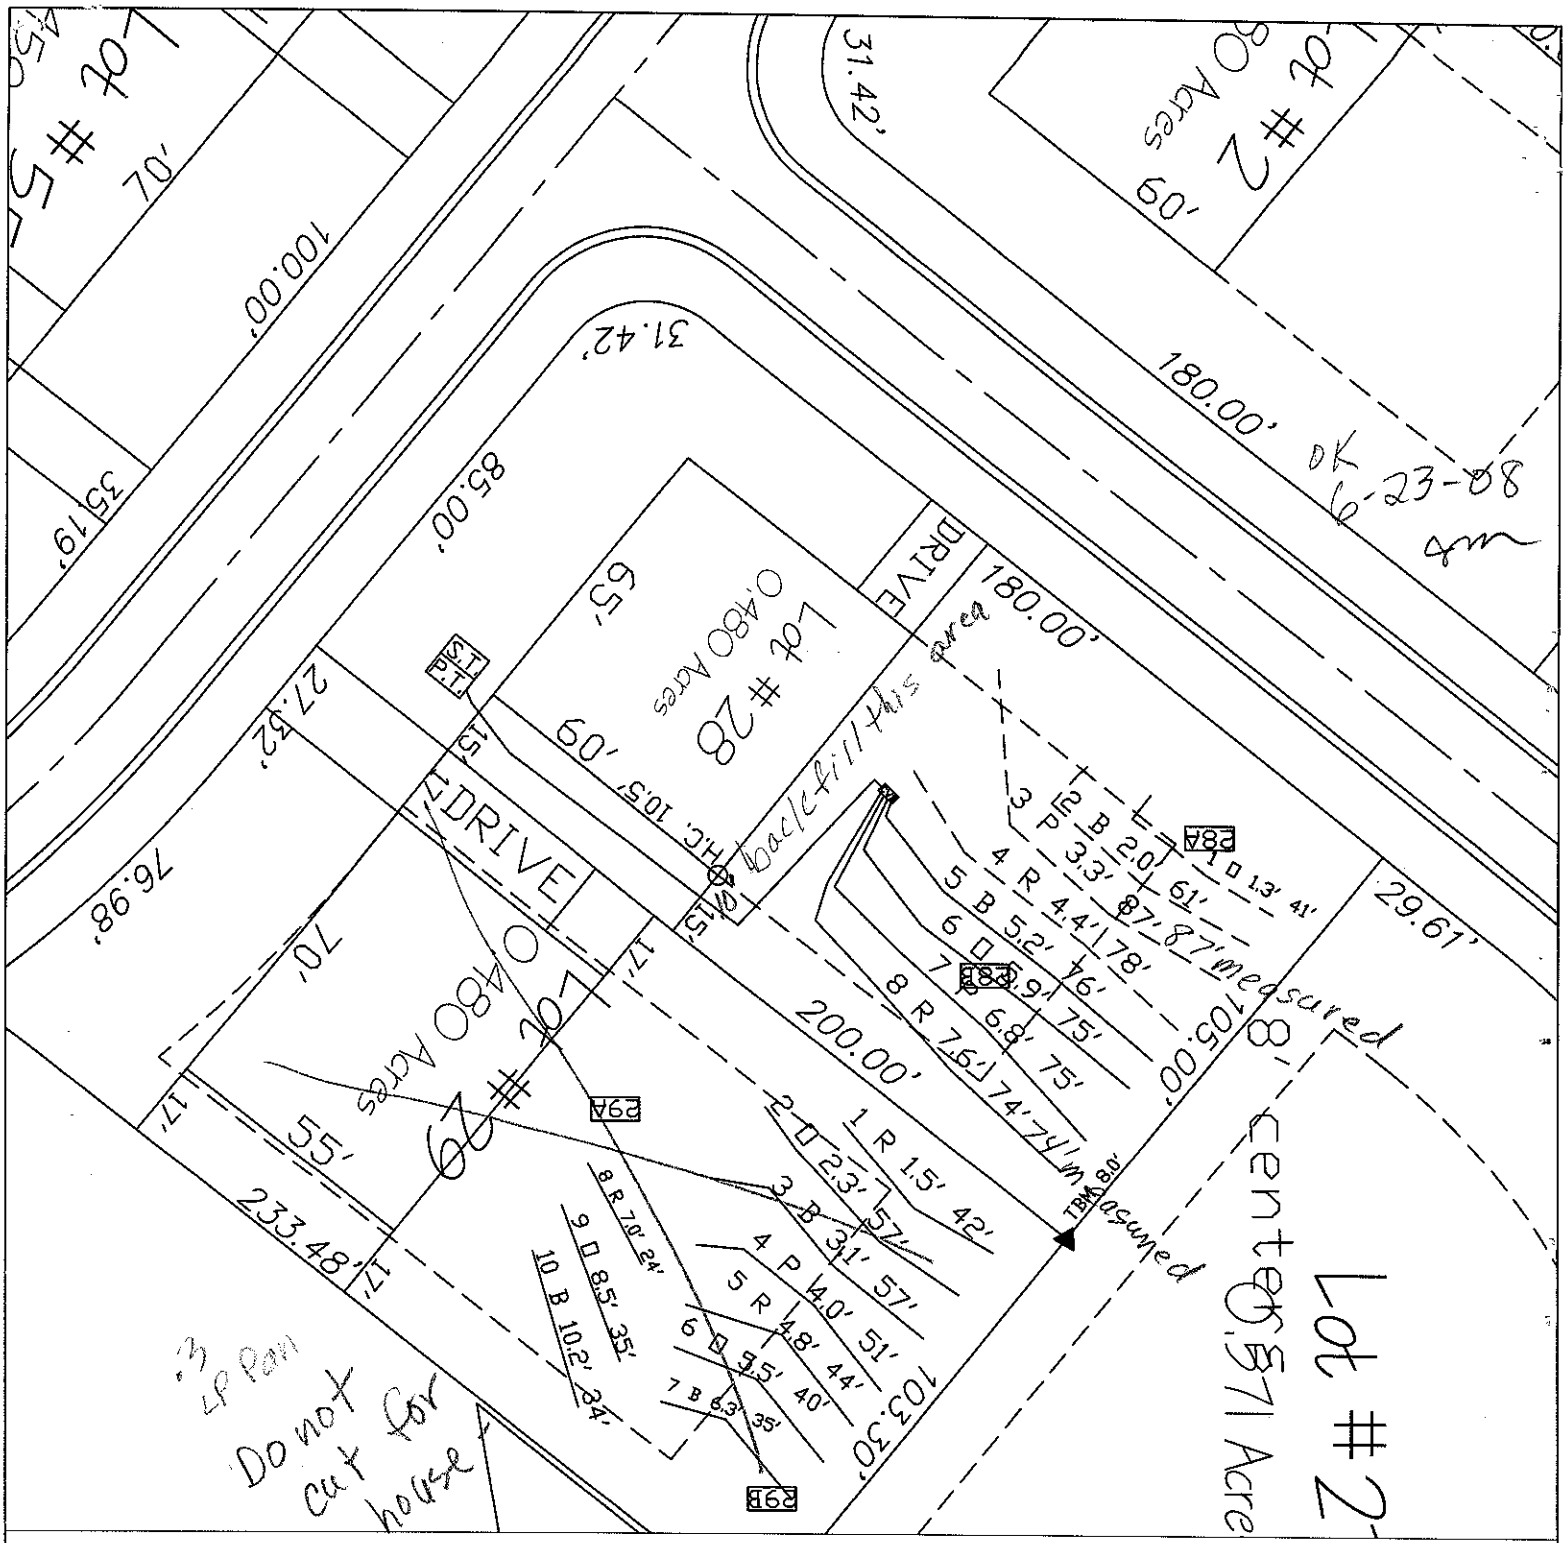

ROLLANS SOIL & ENVIRONMENTAL SERVICES
470 N. BROAD ST., SUITE D
MOORESVILLE, NC 28115
PHONE/FAX: (704) 658-1723
ASHLEY ROLLANS, NC LICENSED SOIL SCIENTIST
MOBILE: (704) 746-5046
EMAIL: ROLLANS@WINDSTREAM.NET

MAP TITLE: PRELIMINARY SOIL EVALUATION

PROJECT NAME: THE JOHNSON GROUP / AUTUMN WOODS

LOCATION/DATE: WALLACE SPRINGS ROAD, IREDELL COUNTY, NORTH CAROLINA, JUNE 2008

JOB # :	01-1439
FILE:	C:\JOBS\01-1439
PROJECT MGR.:	A.L.P
FIELD WORK:	A.L.P
DRAWN BY:	A.L.P