IREDELL COUNTY HEALTH DEPARTMENT

Statesville Phone TR 3-7271 Mooresville Phone NO 3-1271

PERMIT TO INSTALL SEPTIC TANK

Permit No. BILL ANDERSON Permit Date 6-11 1964

Owner Bla CARL BUSH Address STATESVILLE

Installed By BILL MARTIN Address STATESVILLE


Location of Property NEXT DOOR TO GRAVE YARD ON WALLACE SPRINGS RD. ON RIGHT 200 FT OFF ROAD

Tank		Capacity		Length of Lines		Fixtures	
Block	( )	1000	(✓)	225'	(✓)	No. of Baths	(1)
Precast	(✓)	1250	( )	250'	( )	Dishwasher	( )
		1500	( )	Other		Garbage Grdr.	( )
		Other				Other	

NOTIFY HEALTH DEPARTMENT AT LEAST EIGHT HOURS BEFORE TANK IS TO BE INSPECTED.

Final Inspection 6-11 1964 Approved (✓) Disapproved ( )

Remarks

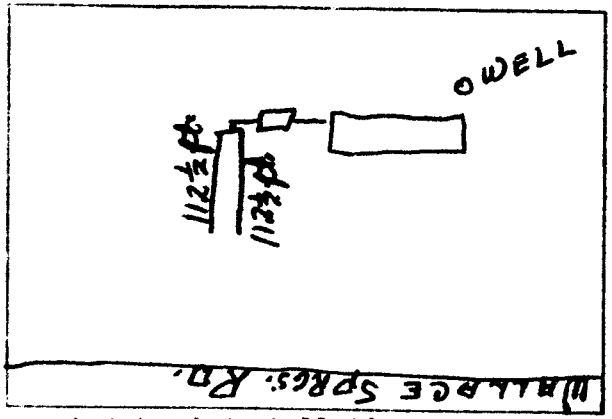

Sketch of Installation

(Ref)

Sanitarian