IREDELL COUNTY HEALTH DEPARTMENT

Statesville Office (704) 878-5305 Mooresville Office (704) 660-3625 PERMIT # 206708

IMPROVEMENT PERMIT / AUTHORIZATION TO CONSTRUCT / OPERATION PERMIT / EXISTING SYSTEM

PIN # 4732 13 47 81

APPLICANT: Wesley Howard APPLICANT ADDRESS: 4832 Burris Rd Denver NC 28037

SITE ADDRESS: 427 Old Mountain Rd Statesville NC PHONE: 704-400-4593 ALT. PHONE: 704-902-3734


SITE DIRECTIONS: 115 S to Old Mountain Rd House on left past South Iredell High School

SUBDIVISION: N/A SECTION: N/A LOT # N/A LOT AREA: 0.68ac DESIGN FLOW: Ex L.T.A.R.: Ex


Septic Tank	Ex (gal)	STB	Date	☐ New System ☐ Repair ☐ Expansion System Type: I ☒ II III IV V VI	☒ Residence	No. Bedrooms	Ex	Water Supply	
Pump Tank	(gal)	PT	Date	System Description: Existing	☐ Business	No. Persons	Ex	☒ Private	
Pump Make	Model		Serial #	Repair System Description:	☐ Other	No. Employees		☐ Public	
# Nitrification Fields	Ex # Lines	Ex	Linear Ft: Ex	Maintenance Agreement Required: ☐ YES ☒ NO	☐ Slab	☒ Crawl Space		☐ Community	
Trench Width	Ex Max. Trench Bottom Depth	Ex	Gravel Depth Ex	☒ GRAVITY ☐ PRESSURE	☐ Basement w/plumbing			☐ Basement w/o plumbing	

Comments / Conditions: All building foundations must be 35' from any part of STS and 325' from any well.

INITIAL SITE SKETCH

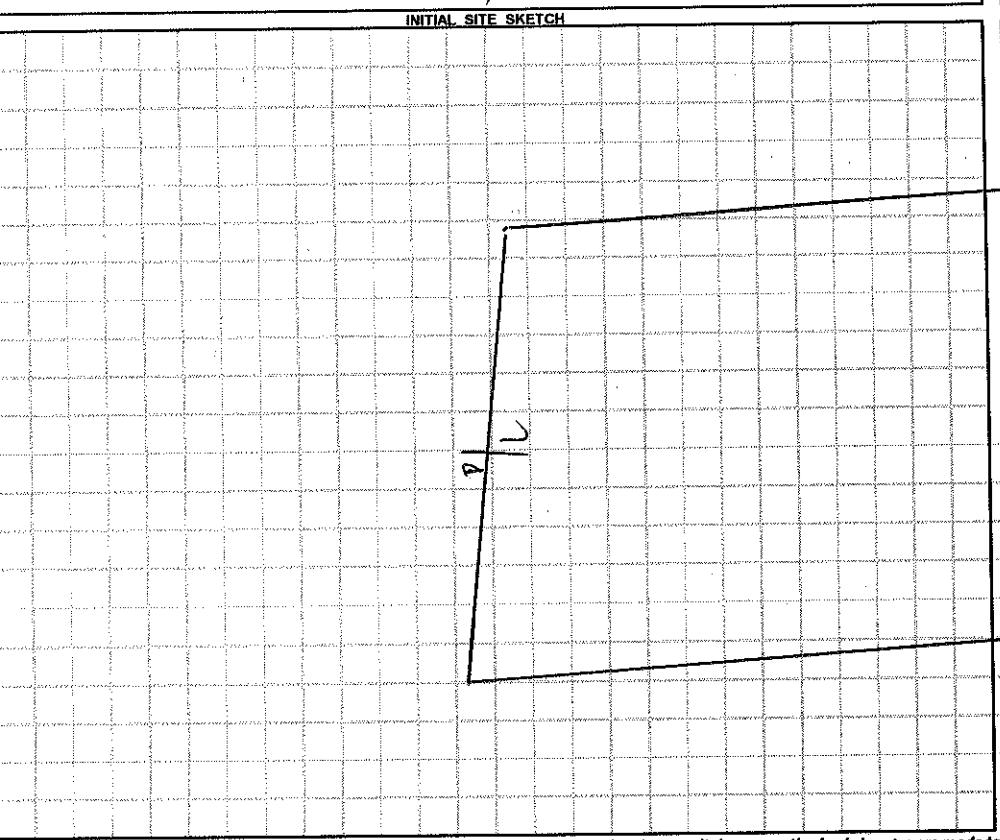

AS BUILT SKETCH

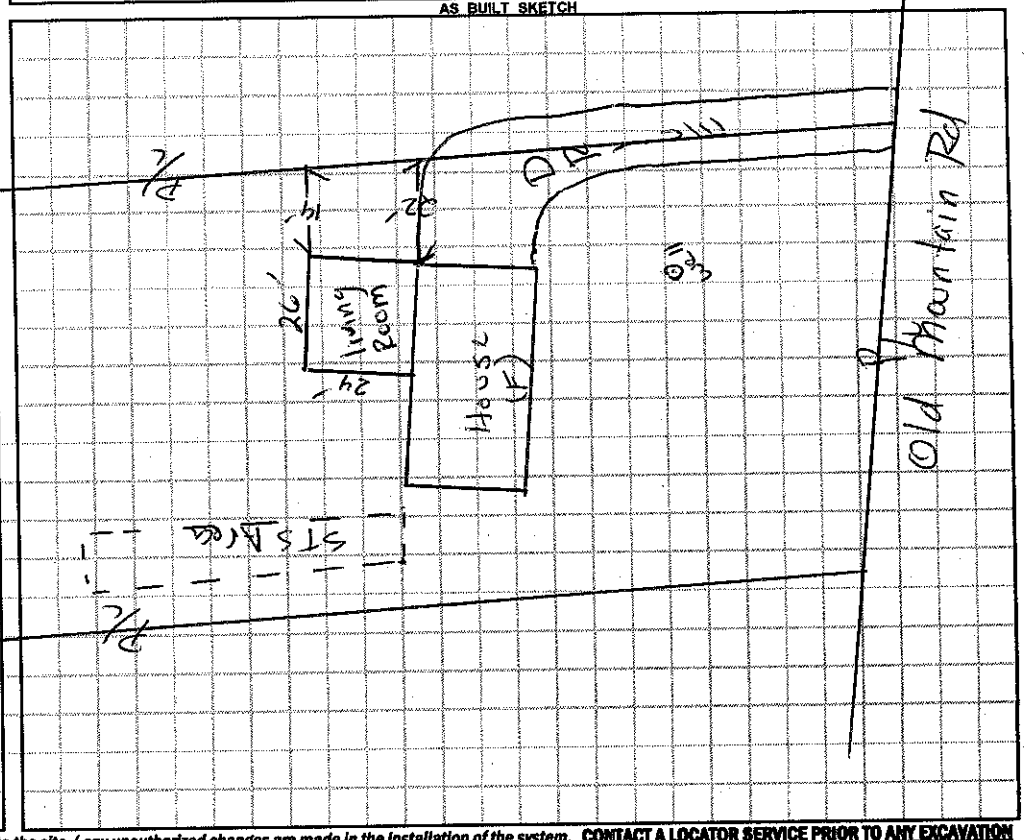

Permit can be suspended or revoked if any false information is supplied toward securing the permit / any unauthorized changes are made to the site / any unauthorized changes are made in the installation of the system. **CONTACT A LOCATOR SERVICE PRIOR TO ANY EXCAVATION**

☐ **IMPROVEMENT PERMIT** *with plat valid without expiration.* ☐ **IMPROVEMENT PERMIT** *with site plan valid for 60 mos.* ☐ **AUTHORIZATION TO CONSTRUCT** *valid for period equal to IMPROVEMENT PERMIT--not to exceed 60 mo.*

Owner / Applicant Signature: Wesley Howard Date: 12/2/14 Installed by:

IMPROVEMENT PERMIT by: Date: OPERATION PERMIT by: Date:

AUTHORIZATION TO CONSTRUCT by: Date: Existing System Inspected by: Robert H. Lee Date: 12/02/14

Health Dept. Copy - WHITE Applicant (Final Approval) - YELLOW Applicant (Conditional Approval) - PINK