IREDELL COUNTY HEALTH DEPARTMENT

Statesville Phone TR 3-7271 Mooresville Phone NO 3-1271

PERMIT TO INSTALL SEPTIC TANK

Permit No. 41 Permit Date 6-3 8 19 71

Owner Gene Troutman Address [redacted] Trout...

Installed By Lacky Brothers Address [redacted] Toy Point.


Location of Property Old Mountain Road above [redacted] South Iredell High School on left.

Tank		Capacity		Length of Lines		Fixtures	
Block	( )	1000	(✓)	225'	( )	No. of Baths	(2)
Precast	(✓)	1250	( )	250'	( )	Dishwasher	( )
		1500	( )	Other 2 Hd		Garbage Grdr.	( )
		Other				Other	

NOTIFY HEALTH DEPARTMENT AT LEAST EIGHT HOURS BEFORE TANK IS TO BE INSPECTED.

Final Inspection 19 Approved ( ) Disapproved ( )

Remarks No well, House No 1.

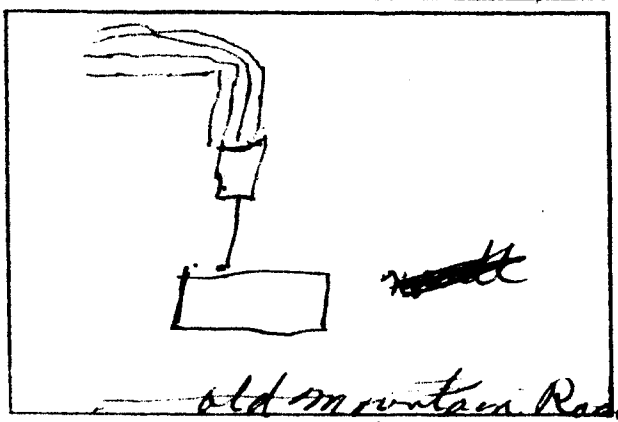

Sketch of Installation

C.S.H.

Sanitarian