IREDELL COUNTY HEALTH DEPARTMENT

STATESVILLE 704-878-5305 MOORESVILLE 704-664-5281

IMPROVEMENT PERMIT / AUTHORIZATION TO CONSTRUCT / OPERATION PERMIT / EXISTING SYSTEM INSPECTION

PERMIT# 137213 PIN# 4732-14-3028 DATE 8-4-06

OWNER OR APPLICANT DAVID MEEHAN PHONE: Business 704-902-0816 Home 704-528-6378

ADDRESS 105 GALAX DR Statesville NC 28677

LOCATION 21 SOUTH (E) OLD OLIN RD ON LEFT BY SOUTHWOOD RD

SUBDIVISION ~~SOUTHWOOD~~ BLOCK / SECTION LOT 11-16 LOT AREA 1.521 AC SITE CLASS. PS DESIGN FLOW 360 L.T.A.R. .3

Septic Tank: 1000 Gallons; STB 1012 Date 5-21-06
Pump Tank: Gallons; PT Date
Pump Make: Model Serial No.
Nitrification Field: No Fields 1 Square Feet EU=1200' Linear Feet 300'
No Lines 4 Trench Width 36" Max Trench Bottom Depth 30"

☒ New System ☐ Repair ☐ Expansion System Type: I II III IV V VI
System Description: 60MM 25% REDUCTION
Repair System Description: LP SD'L
Maintenance Agreement Required: ☐ Yes ☒ No


☒ House/Mod. Home ☐ Mobile Home ☐ Business ☐ Other
No. Bedrooms 3 No. Persons 6 No. Employees

Water Supply: ☒ Individual ☐ Public ☐ Community

Gravel Depth N/A ☒ Gravity ☐ Pressure ☐ Slab ☒ Crawl Space ☐ Basement w/plumbing ☐ Basement wo/plumbing


Comments/Conditions: ① STUB OUT THROUGH GARAGE AS DRAWN ② INSTALL LINES ON CONTOURS ③ INSTALL LINES NO DEEPER THAN 30" DEEP DUE TO SAPROLITE ④ USE DISTRIBUTION BOX WITH 1" = 50

INITIAL SITE SKETCH

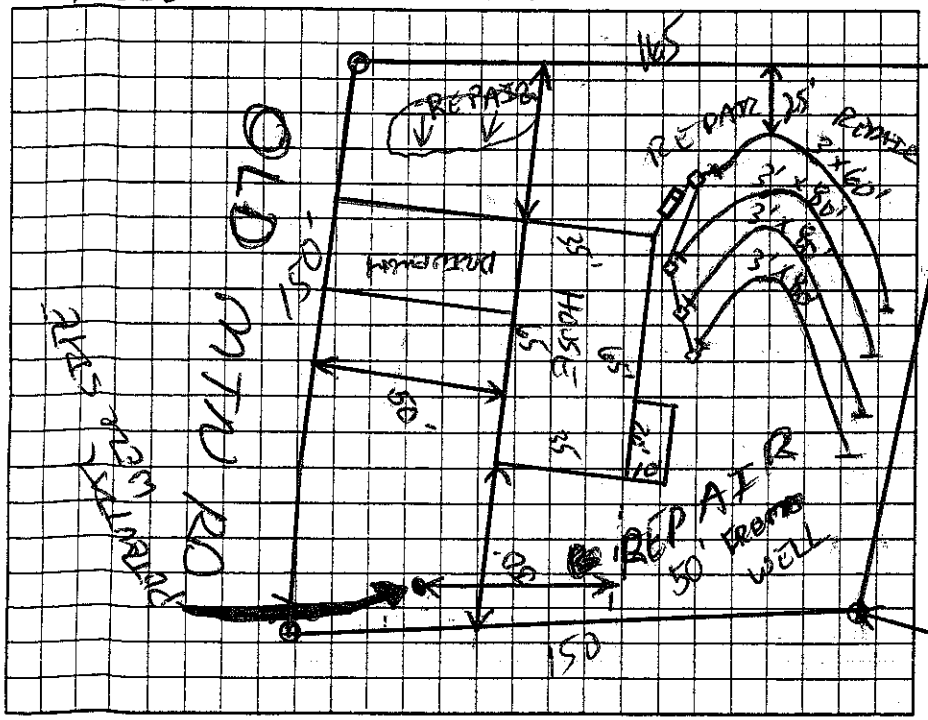

Comments/Conditions: SPEED LEVELERS TO WORK AS A DROP BOX AND TO KEEP LINES SHALLOW.

AS BUILT SKETCH

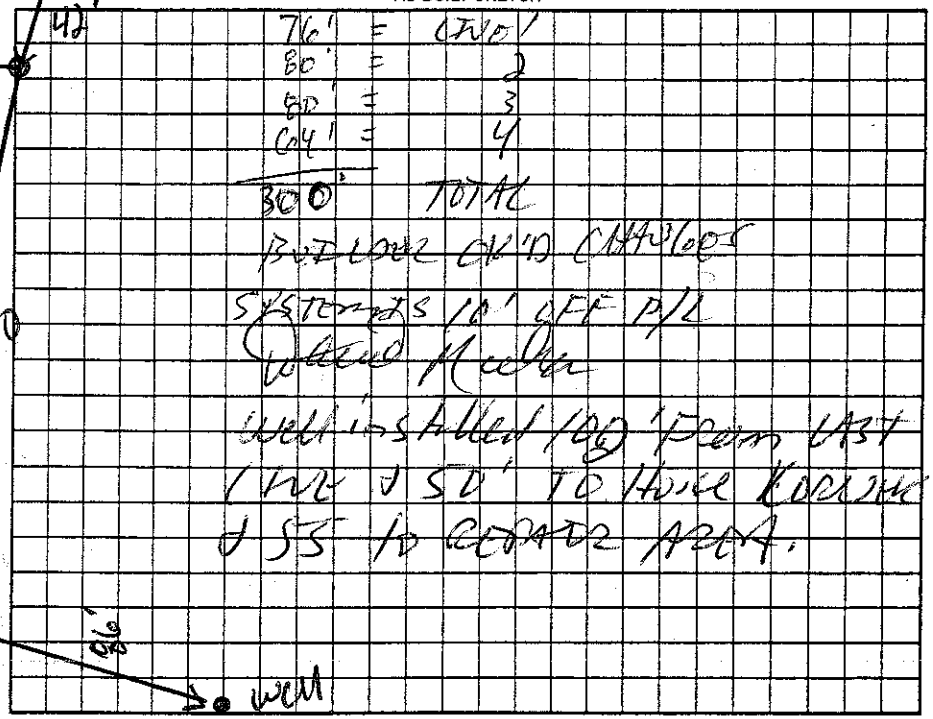

Permit can be suspended or revoked if any false information is supplied toward securing the permit/any unauthorized changes are made to the site/any unauthorized changes are made in the installation of the system. Improvement Permit with plat valid without expiration ☐ Improvement Permit with site plan valid for sixty months ☒ Authorization to Construct is valid for a period equal to that of Improvement Permit – not to exceed sixty months.

Signed: Daniel A Meehan date 8-7-06 Installed by: A-1 BACKHOE

Improvement Permit by: date 8-4-06 Operation Permit by: date 11-13-06

Authorization to Construct by: date 8-4-06 Existing System Inspection by: date

HEALTH DEPT. COPY: WHITE OWNER COPY (FINAL): YELLOW OWNER COPY (INITIAL): PINK