IREDELL COUNTY HEALTH DEPARTMENT - *ENVIRONMENTAL HEALTH* ☐ STATESVILLE OFFICE 704-878-5305 ☐ MOORESVILLE OFFICE 704-664-5281

IMPROVEMENT PERMIT / AUTHORIZATION TO CONSTRUCT / OPERATION PERMIT / EXISTING SYSTEM INSPECTION

PERMIT # 16457G PIN # 4732 14 4443 DATE 12-20-10

OWNER David Ream APPLICANT: Central Piedmont Bldrs PHONE: Home/Cell # 704 638 2076 Business #

SITE ADDRESS 458 Old Mtn. Rd, Statesville OWNER / APPLICANT ADDRESS PO Box 4041 Salisbury NC

SITE DIRECTIONS From US 21 N 115, Old Mtn. Rd past 5. Treated high on ¼-¼ mile on right

SUBDIVISION BLOCK / SECTION LOT # LOT AREA acreage DESIGN FLOW 480 gpd L.T.A.R. .3

Septic Tank Existing Gallons: STB Date
Pump Tank Gallons: P T Date
Pump Make Model Serial #
No. Nitrification Fields: 1 No. Lines 4 Linear Feet 400
Trench Width 36" Max. Trench Bottom Depth 36" Gravel Depth NA


☐ New System ☑ Repair ☐ Expansion System Type I II (III) IV V VI
System Description:
Repair System Description: Gravity 25% Reduction
Maintenance Agreement Required ☐ YES ☒ NO
☑ GRAVITY ☐ PRESSURE

☒ Residence No. Bedrooms 4
☐ Business No. Persons
☐ Other No. Employees
☐ Slab ☐ Crawl Space
☐ Basement w/plumbing ☐ Basement w/o plumbing


Water Supply: ☒ Private ☐ Public ☐ Community

Comments / Conditions Remodeling kitchen + adding sitting room. OK to issue building permit. Hold final pld approval until septic system repaired. * Its taller/Pumper - pump existing tank and check condition. Replace w/ 1000 tank if needed. Disconnect old line

INITIAL SITE SKETCH

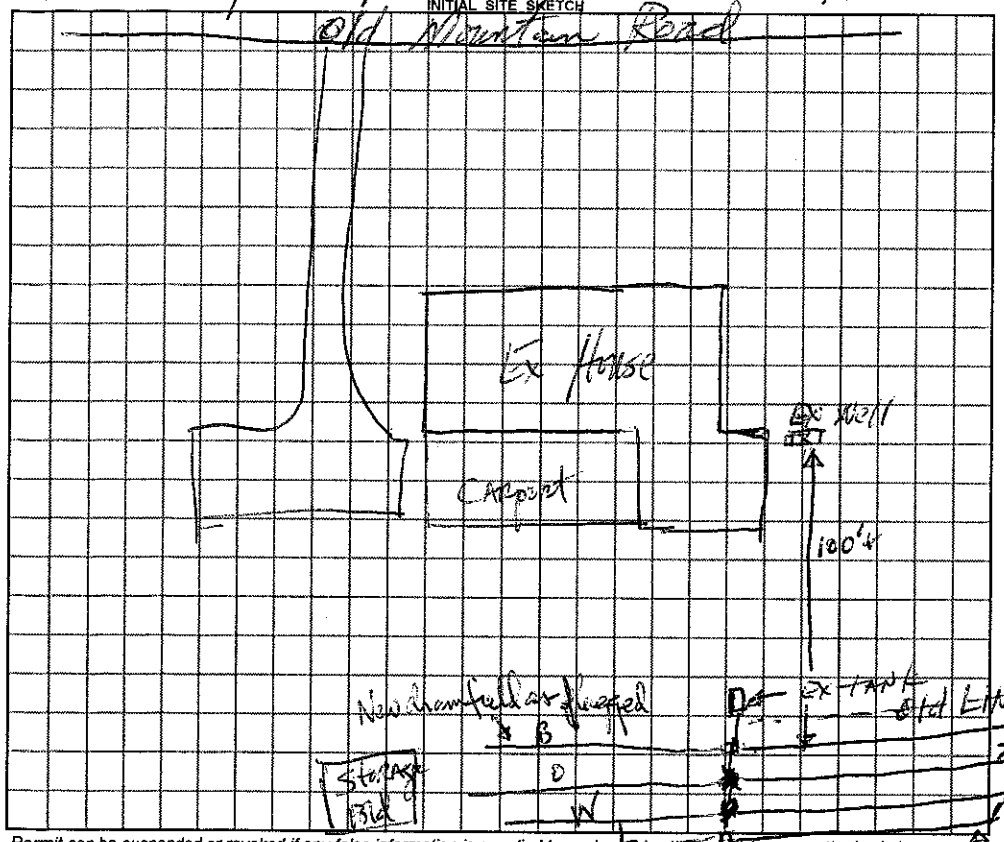

AS BUILT SKETCH

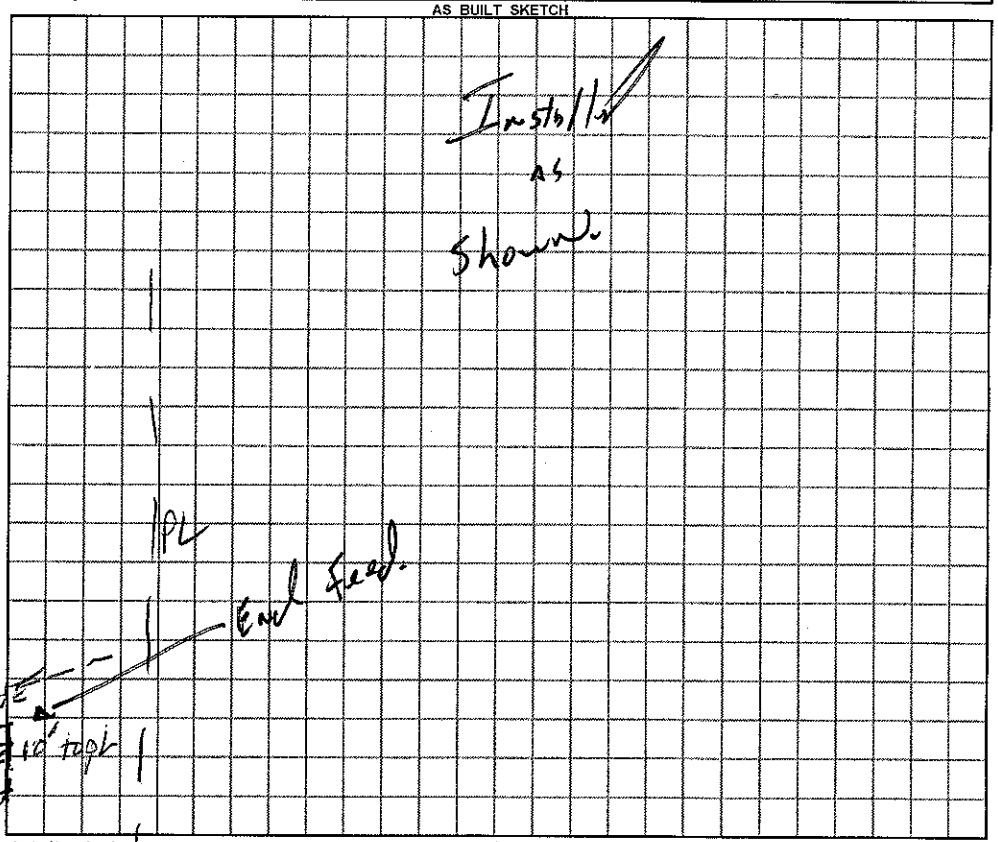

Permit can be suspended or revoked if any false information is supplied toward securing the permit / any unauthorized changes are made to the site / any unauthorized changes are made in the installation of the system.

☐ ***IMPROVEMENT PERMIT*** with plat valid without expiration. ☐ ***IMPROVEMENT PERMIT*** with plat valid without expiration. ☑ ***AUTHORIZATION TO CONSTRUCT*** valid for period equal to IMPROVEMENT PERMIT–not to exceed 60 mo.

Owner / Applicant Signature: X Patsy Date 12/20/10 Installed by: Randy Miller

IMPROVEMENT PERMIT by: ***REHS*** Date

AUTHORIZATION TO CONSTRUCT by: ***REHS*** Date 12-20-10

OPERATION PERMIT by: ***REHS*** Date 17 Feb. 11

Existing System Inspected by: ***REHS*** Date

YOU SHOULD CONTACT A LOCATOR SERVICE PRIOR TO ANY EXCAVATION

White Copy – Environmental Health YELLOW COPY (Final) Owner / Applicant PINK COPY (Initial) Owner / Applicant