IREDELL COUNTY HEALTH DEPARTMENT

STATESVILLE 704-878-5305 (C) MOORESVILLE 704-664-5281

IMPROVEMENT PERMIT / AUTHORIZATION TO CONSTRUCT / OPERATION PERMIT / EXISTING SYSTEM INSPECTION

PERMIT# ~~TROUTMAN~~ 120877 PIN# 4732 ~~02 8097~~ 220388 DATE 3-17-04

OWNER OR CONTRACTOR JAMIE WELLS PHONE: Business Home 828-241-3576

ADDRESS 5910 SHERRILLS FORD ROAD, CATAWBA, NC 28609

LOCATION US 21 SOUTH, TR OLD MOUNTAIN ROAD, 1.0 MILE ON LEFT AT BOX #367

SUBDIVISION BLOCK / SECTION LOT LOT AREA 1.958 ACRES SITE CLASS. PS DESIGN FLOW 480 L.T.A.R. 0.35 GPD/FT²

Septic Tank: 1000 Gallons; STB 760 Date 3-24-04

Pump Tank: Gallons; PT Date

Pump Make: Model Serial No.

Nitrification Field: No Fields 1 Square Feet 1380 Linear Feet 460

No Lines FOUR Trench Width 36" Max Trench Bottom Depth 36" Gravel Depth 12"

☑ New System ☐ Repair System Type: I, II, III, IV, V, VI

System Description: CONVENTIONAL, GRAVITY

Repair System Description: CONVENTIONAL, GRAVITY, PUMP

Maintenance Agreement Required: ☐ Yes ☐ No

☐ House/Mod. Home ☑ Mobile Home ☐ Business ☐ Other

No. Bedrooms 4 No. Bathrooms 2 No. Employees


☐ Slab ☑ Crawl Space ☐ Basement w/plumbing ☐ Basement wo/plumbing

Water Supply: ☑ Individual ☐ Public ☐ Community WELL


Comments:/Conditions: KEEP SYSTEM MINIMUM 100' FROM WELL

Comments:/Conditions: SEPTIC TANK WITH RISERS INSTALLED USING 1" ~~ZABEL~~ ABEE FILTER

INITIAL SITE SKETCH

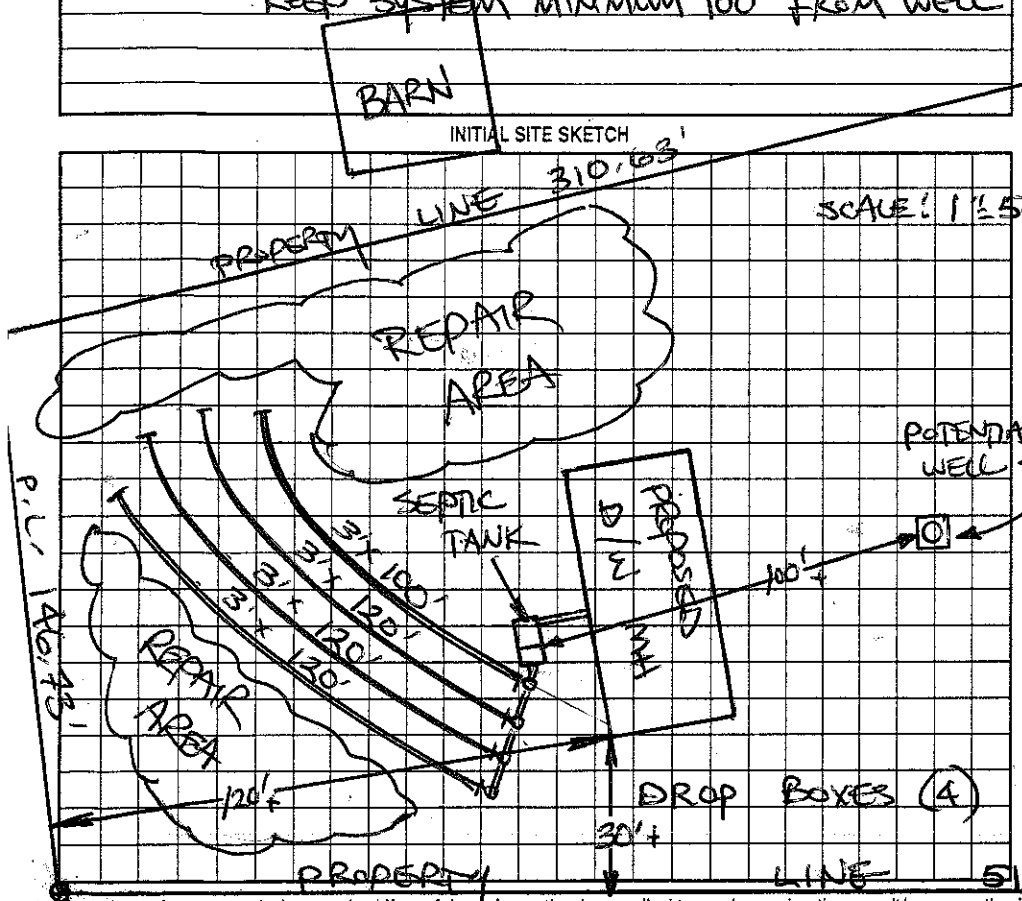

AS BUILT SKETCH

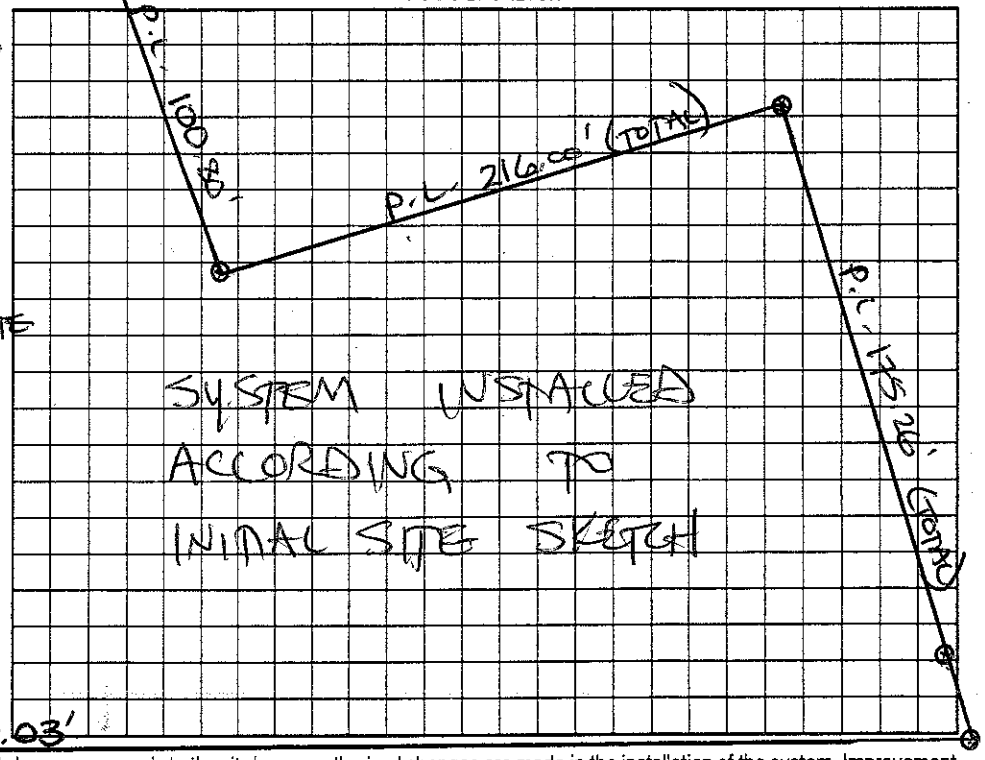

Permit can be suspended or revoked if any false information is supplied toward securing the permit/any unauthorized changes are made to the site/any unauthorized changes are made in the installation of the system. Improvement Permit with plat valid without expiration. Improvement Permit with site plan valid for sixty months. Authorization to Construct is valid for a period equal to that of Improvement Permit – not to exceed sixty months.

Signed: Jamie W. Wells date 3-18-04

Improvement Permit by: STEVE HENDRICK date 3-17-04

Authorization to Construct by: STEVE HENDRICK date 3-18-04

Installed by: ABEE GRADING

Operation Permit by: STEVE HENDRICK date 5-26-04

Existing System Inspection by: date

HEALTH DEPT. COPY: WHITE OWNER COPY (FINAL): YELLOW OWNER COPY (INITIAL): PINK