IREDELL COUNTY HEALTH DEPARTMENT

Statesville Phone TR 3-7271 Mooresville Phone NO 3-1271

PERMIT TO INSTALL SEPTIC TANK

Permit NO._____ Permit Date Jan 22 1960

Owner Mr. Caldwell Address_____

Installed By H. HEDRICK Address_____


Location of Property DOWN OLD MTN ROAD FROM WALLACE SPGS ROAD. 3rd New Brick home on right

Tank		Capacity		Length of Lines		Fixtures	
Block	( )	800	( )	150'	(✓)	No. of Baths	(1)
Precast	(✓)	900	(✓)	175'	( )	Dishwasher	( )
		1000	( )	200'	( )	Garbage Grdr.	( )
		1100	( )	225'	( )	Auto-Washer	( )
		1200	( )	250'	( )	Other_____	
		Other_____		Other_____			

NOTIFY HEALTH DEPARTMENT AT LEAST EIGHT HOURS BEFORE TANK IS TO BE INSPECTED.

Final Inspection Jan 22 1960 Approved (✓) Disapproved ( )

Remarks_____

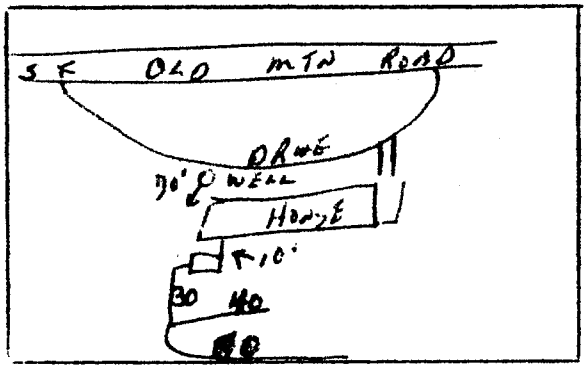

Sketch of Installation

Rayford A Hood

Sanitarian