IREDELL COUNTY HEALTH DEPARTMENT

Statesville Phone TR 3-7271 Mooresville Phone No. 664-5281

PERMIT TO INSTALL SEPTIC TANK

Permit No. _____ Permit Date 5-7 1973

Owner Sieg Keller Address Statesville N.C.

Installed By Lackey Bro Address Stony Point N.C.


Location of Property Old Mountain Rd. Trl. into drive at 1st Trailer behind Wallace Springs Rd. House back off of road

Tank		Capacity		Length of Lines		Fixtures	
Block	( )	1000	( )	225'	( )	No. of Baths	(3)
Precast	(✓)	1250	(✓)	250'	( )	Dishwasher	(✓)
		1500	( )	Other 300		Garbage Grdr.	( )
		Other _____				Other _____	

NOTIFY HEALTH DEPARTMENT AT LEAST EIGHT HOURS BEFORE TANK IS TO BE INSPECTED.

Final Inspection 5-9 1973 Approved (✓) Disapproved ( )

Remarks Well more than 100' away

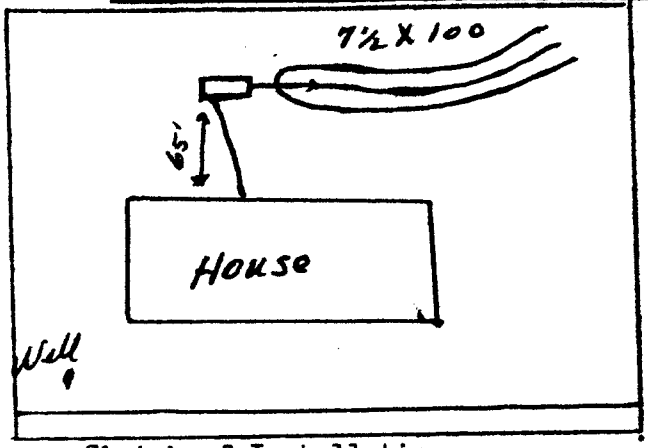

Sketch of Installation

E. A. Stevenson

Sanitarian