ICHD - ENVIRONMENTAL HEALTH DIVISION

Statesville Office (704) 878-5305 Mooresville Office (704) 660-3625 PERMIT # 2023-27217

SEPTIC: IMPROVEMENT PERMIT / AUTHORIZATION TO CONSTRUCT / OPERATION PERMIT / EXISTING SYSTEM Repair PIN # 4732 -- 30 -- 4078

APPLICANT/OWNER: Ben Henkel APPLICANT ADDRESS: 138 Parkwood Ln

SITE ADDRESS: 138 Parkwood Ln, Statesville 28677 PHONE: ALT. PHONE


SITE DIRECTIONS: Old Mtn - E Monbo - Parkwood SAP CONTROLLED: ☐ YES ☐ NO

SUBDIVISION: Parkwood Acres SECTION: - LOT # 1 LOT AREA: 0.78 acres DESIGN FLOW: EX L.T.A.R.: EX

Septic Tank	1000	(gal)	STB 760	Date 5/13/23	☐ New System	☒ Repair	☐ Expansion	System Type: I (II) III IV V VI	☒ Residence	No. Bedrooms	EX	Water Supply
Pump Tank		(gal)	PT	Date	System Description:				☐ Business	No. Persons	EX	☒ Private
Pump Make		Model		Serial #	Repair System Description:	Tank Replacement			☐ Other	No. Employees		☐ Public
# Nitrification Fields	EX	# Lines	EX	Linear Ft EX	Maintenance Agreement Required:	☐ YES	☒ NO		☐ Slab	☒ Crawl Space		☐ Community
Trench Width	EX	Trench Bottom Depth(Low side)	EX	Gravel Depth EX	☒ GRAVITY	☐ PRESSURE			☐ Basement w/plumbing		☐ Basement w/o plumbing	

Comments / Conditions: Pump, crush, & fill old septic tank. Cut bed 50' from existing well.

INITIAL SITE SKETCH

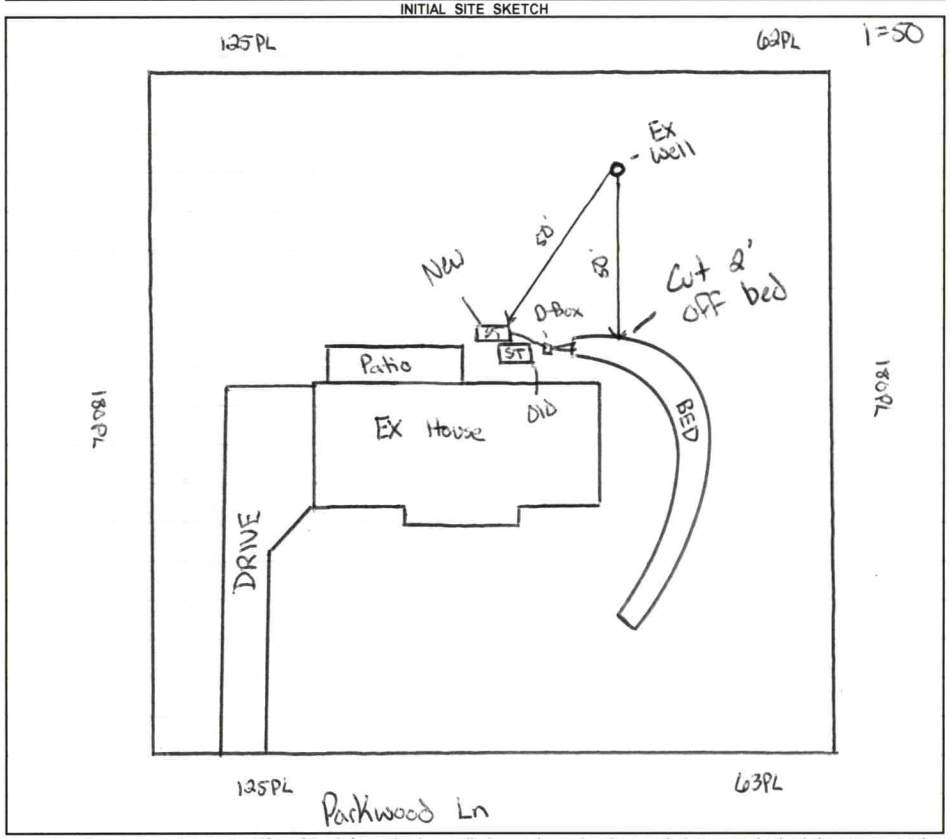

AS BUILT SKETCH

FOR SEPTIC FINAL INSPECTION CALL: 704-664-3703 between 8am-9am the day the inspection is needed. Be sure to speak with an inspector to confirm your time.

Installed as Drawn

Permit can be suspended or revoked if any false information is supplied toward securing the permit / any unauthorized changes are made to the site / any unauthorized changes are made in the installation of the system. **CONTACT A LOCATOR SERVICE PRIOR TO ANY EXCAVATION**

☐ **IMPROVEMENT PERMIT** ***with plat*** *valid without expiration.* ☒ **IMPROVEMENT PERMIT** ***with site plan*** *valid for 60 mos.* ☒ **AUTHORIZATION TO CONSTRUCT** *valid for period equal to IMPROVEMENT PERMIT--not to exceed 60 mo.*

Owner / Applicant Signature: Online Signature Date: Installed by: Piedmont Backhoe


IMPROVEMENT PERMIT by: Cory Whitt Date: 6/8/23 OPERATION PERMIT by: Cory Whitt Date: 7/5/23

AUTHORIZATION TO CONSTRUCT by: Cory Whitt Date: 6/8/23 Existing System Inspected by: Date:

FOR SEPTIC FINAL INSPECTION: CALL 704-664-3703 between 8am-9am the day the inspection is needed.

Item	Date	Initials
Drain Lines Checked		
Tanks Checked		
Pressure Manifold or Valve Box Checked		
Pressure Head Set		
Electrical Checked		
Floats Set		
Alarm Checked		
Maintenance Contract Needed? Y / N		
Comments:		

Repairs Only	
	State Code
Failing System Code	
Type of Distribution	G or P
Type of Failure/Malfunction	
Primary Cause of Failure/Malfunction	
Age of System? _____	
Initial or Repair? _____	

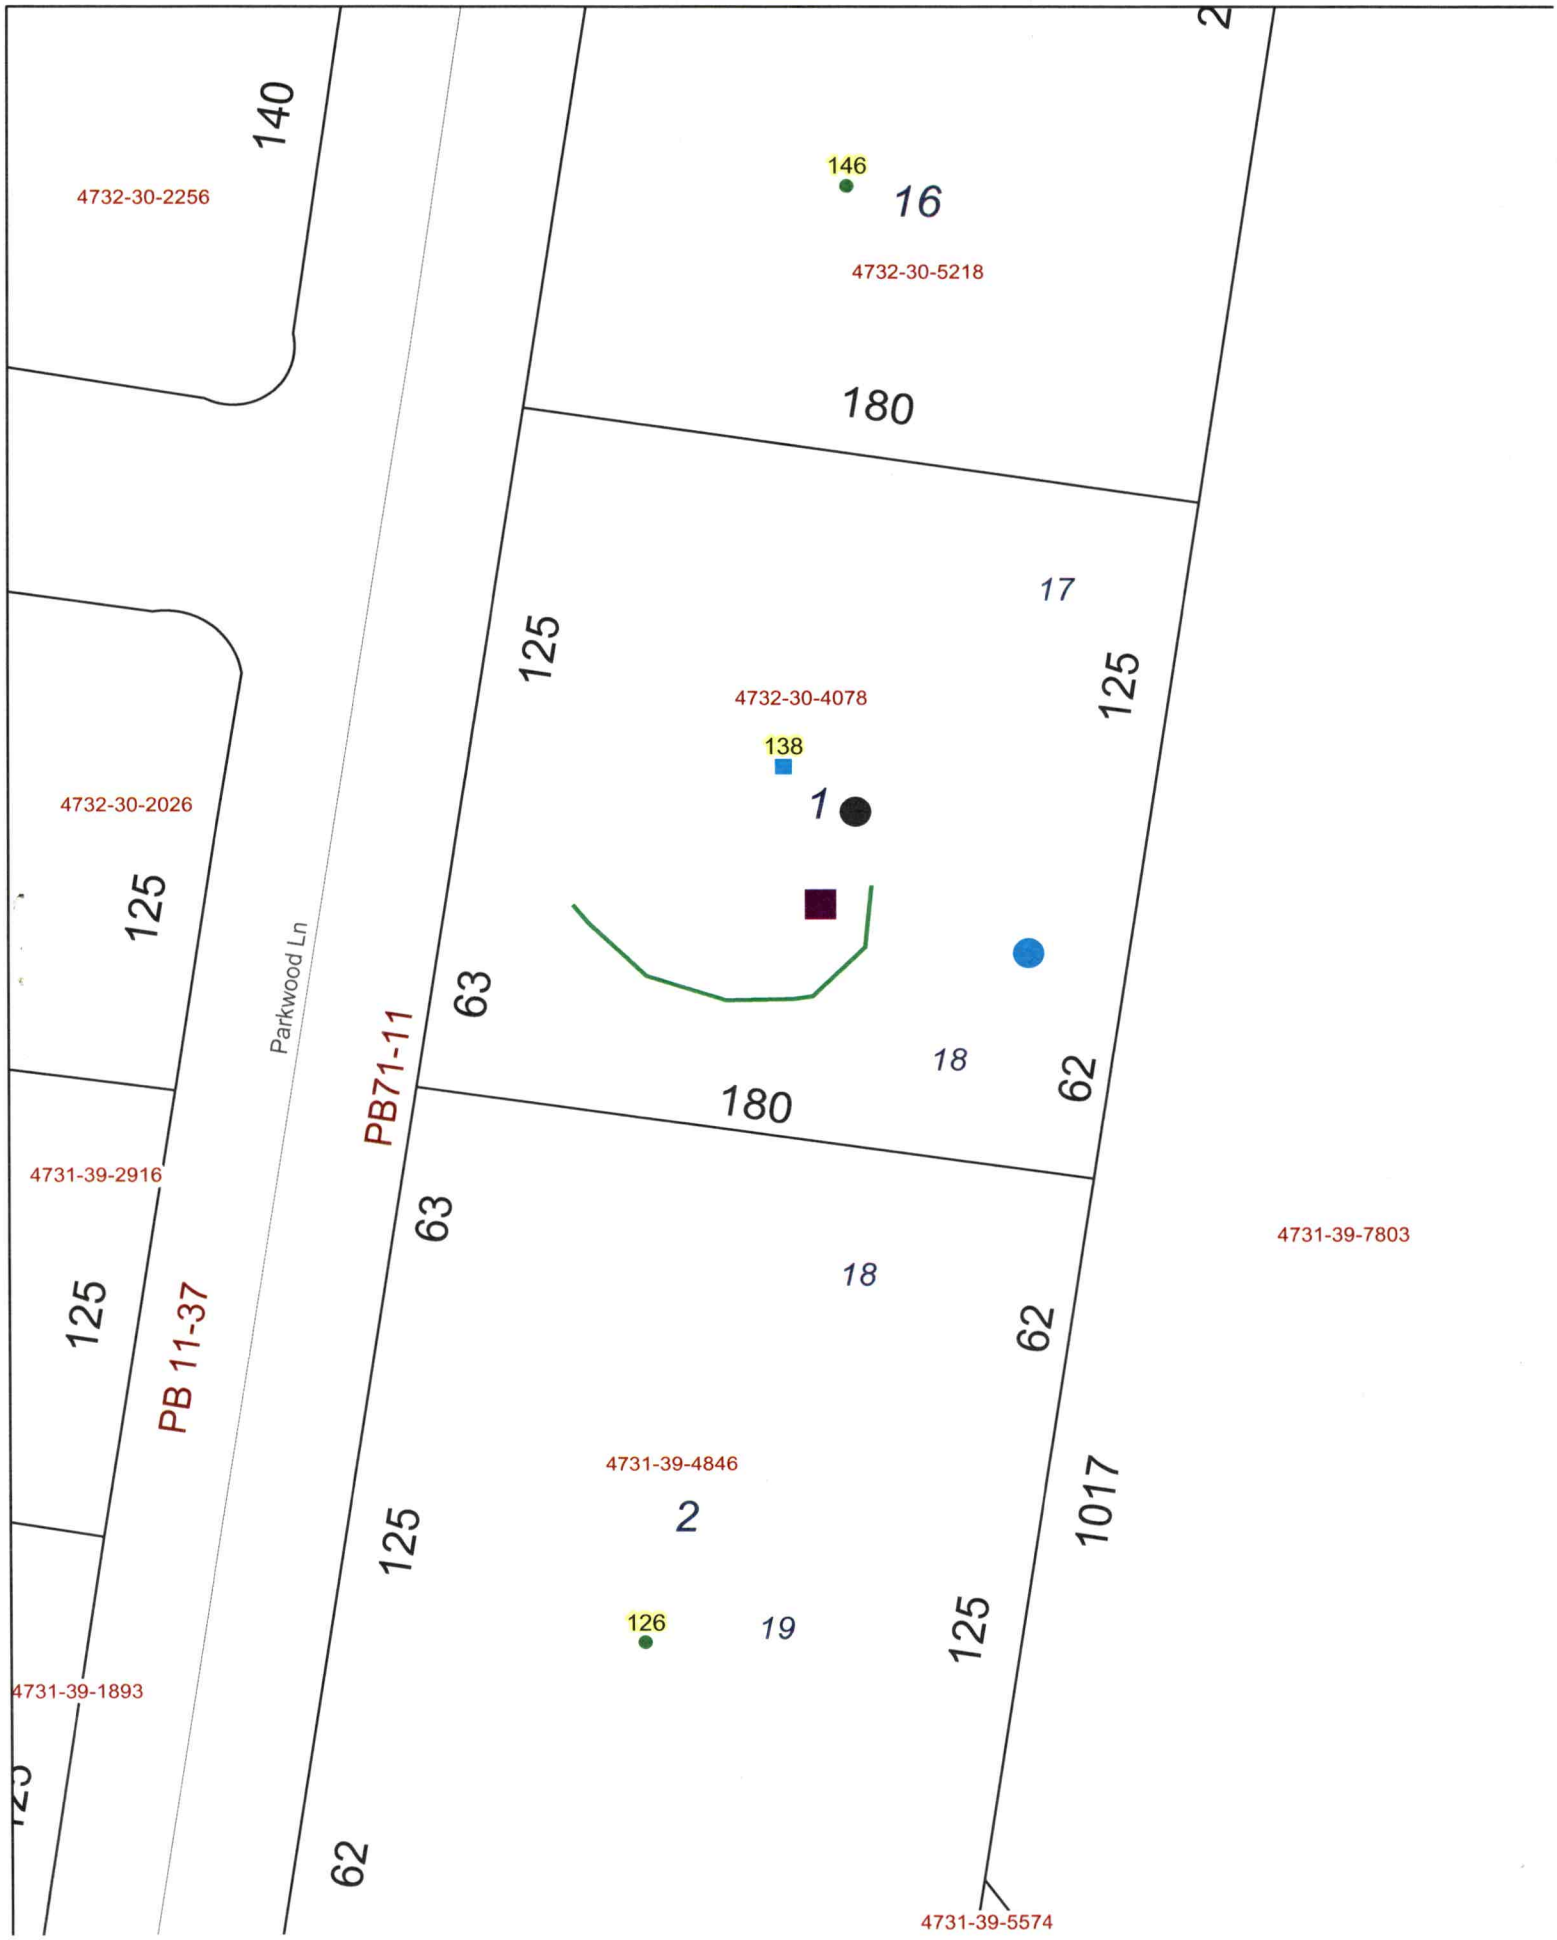
140
4732-30-2256
146
16
4732-30-5218
180
17
125
125
4732-30-4078
138
1
4732-30-2026
125
Parkwood Ln
PB71-11
63
18
62
180
4731-39-2916
63
4731-39-7803
18
125
PB 11-37
62
4731-39-4846
2
125
1017
126
19
125
4731-39-1893
62
4731-39-5574



Tax Map Information

• PIN	4732304078.000
• Address	138 PARKWOOD LN
• Account #	Acct 80067437
• Tax Owner	HENKEL BEN PAUL
• Mailing Address	138 PARKWOOD LN
•	STATESVILLE, NC 28677
• GIS Owner	HENKEL BEN P+LINDSEY S
• Deed Info	2659 / 2272 - WD - 20191121
• Tax Acres	0.78 AC
• Lot #	1
• Description	PARKWOOD ACRES PB11-37 REV P71-11
• Zoning	RS
• Old Parcel #	1503K01000A017
• Bldg Value	$180,970
• OBXF Value	$1,200
• Land Value	$33,000
• Total Value	$215,170
• Defer Value	$0
• Tax Districts	-ALLCNTY FIRE- -

IREDELL COUNTY NC

MAP FOR REFERENCE ONLY
NOT A LEGAL DOCUMENT

Iredell County, North Carolina makes no claims and no warranties, expressed or implied, concerning the validity or accuracy of the GIS data presented on this map.

Geometry updated 06/05/2023
Data updated 06/05/2023

Print map scale is approximate. Critical layout or measurement activities should not be done using this resource.