IREDELL COUNTY HEALTH DEPARTMENT

Statesville Office (704) 878-5305 Mooresville Office (704) 660-3625 PERMIT # 212497

IMPROVEMENT PERMIT / AUTHORIZATION TO CONSTRUCT / OPERATION PERMIT / EXISTING SYSTEM

PIN # 4732403009

APPLICANT: Greg Sunseri APPLICANT ADDRESS: 156 E. Monbo Rd.

SITE ADDRESS: 156 E. Monbo PHONE: 714-402-0505 ALT. PHONE: N/A

SITE DIRECTIONS: Hwy 215 TR OH Mtn Rd. TL E. Monbo Rd.

SUBDIVISION: N/A SECTION: N/A LOT # N/A LOT AREA: 1.5 acres DESIGN FLOW: Ex L.T.A.R.: Existing


Septic Tank	Existing (gal)	STB		Date		☐ New System ☐ Repair ☐ Expansion	System Type: I (II) III IV V VI	☑ Residence	No. Bedrooms	Ex	Water Supply
Pump Tank	(gal)	PT		Date		System Description: Existing		☐ Business	No. Persons	Ex	☑ Private
Pump Make		Model		Serial #		Repair System Description:		☐ Other	No. Employees		☐ Public
# Nitrification Fields	Ex	# Lines	Ex	Linear Ft:	Ex	Maintenance Agreement Required:	☐ YES ☑ NO	☐ Slab	☑ Crawl Space		☐ Community
Trench Width	Ex	Max. Trench Bottom Depth	Ex	Gravel Depth	Ex		☑ GRAVITY ☐ PRESSURE	☐ Basement w/plumbing		☐ Basement w/o plumbing	

Comments / Conditions:

Proposed Addition must maintain a minimum set back of 5' from foundation to septic tank system.

INITIAL SITE SKETCH

AS BUILT SKETCH

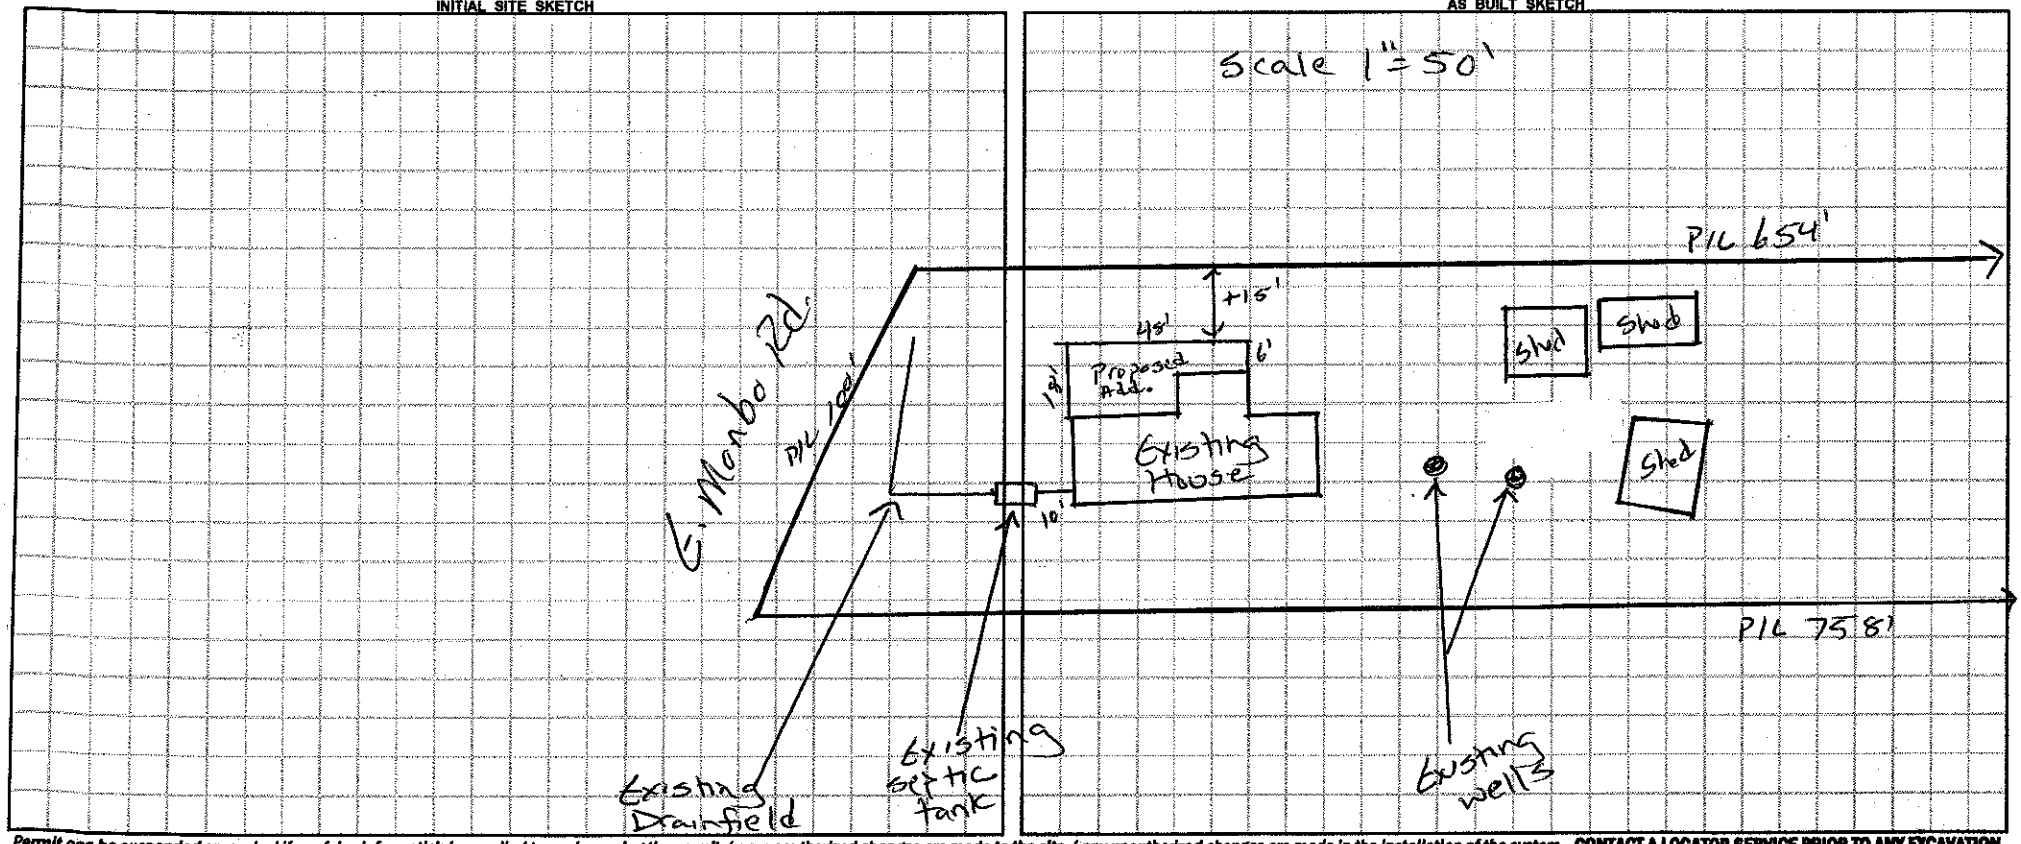

Permit can be suspended or revoked if any false information is supplied toward securing the permit / any unauthorized changes are made to the site / any unauthorized changes are made in the installation of the system. **CONTACT A LOCATOR SERVICE PRIOR TO ANY EXCAVATION**

☐ **IMPROVEMENT PERMIT** *with plat valid without expiration.* ☐ **IMPROVEMENT PERMIT** *with site plan valid for 60 mos.* ☐ **AUTHORIZATION TO CONSTRUCT** *valid for period equal to IMPROVEMENT PERMIT--not to exceed 60 mo.*

Owner / Applicant Signature: [signature] Date: 8-10-2015 Installed by:

IMPROVEMENT PERMIT by: Date: OPERATION PERMIT by: Date:

AUTHORIZATION TO CONSTRUCT by: Date: Existing System Inspected by: [signature] Date: 8-10-15

Health Dept. Copy - WHITE Applicant (Final Approval) - YELLOW Applicant (Conditional Approval) - PINK