IREDELL COUNTY HEALTH DEPARTMENT

Statesville Phone TR 3-7271 Mooresville Phone NO 3-1271

PERMIT TO INSTALL SEPTIC TANK

Permit NO. _____ Permit Date Mar 21 19 63

Owner Collins Address Barium Springs

Installed By C/Hoke Address 127

Location of Property Right on Loop past Children's Home - at Barium - on Rite next to last before


Tank		Capacity		Length of Lines		Fixtures	
Block	( )	800	( )	150'	( )	No. of Baths	(2)
Precast	(✓)	900	( )	175'	( )	Dishwasher	( )
		1000	(✓)	200'	( )	Garbage Grdr.	( )
		1100	( )	225'	( )	Auto-Washer	(✓)
		1200	( )	250'	( )	Other	
		Other		Other 240'			

all inside

NOTIFY HEALTH DEPARTMENT AT LEAST EIGHT HOURS BEFORE TANK IS TO BE INSPECTED.

Final Inspection 3-21 Well 75' 1963 Approved (✓) Disapproved ( )

Remarks Very deep - tank 40" in ground - Not liable for any damages due to grading over

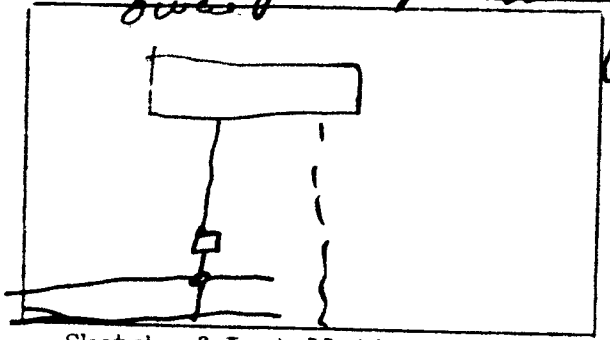

Sketch of Installation

Rat.

Sanitarian