IREDELL COUNTY HEALTH DEPARTMENT

Statesville Phone TR 3-7271 Mooresville Phone NO 3-1271

PERMIT TO INSTALL SEPTIC TANK

Permit No. 35 Permit Date 12 - 28 1971

Owner HAROLD Smith Address Statesville, N.C.

Installed By LACKEY Bros. Address Stony Point, N.C.


Location of Property HIGHWAY 21 S. TURN Rt. BEFORE 76 Station AFTER you PASS IREDELL MEM. PARK. LEFT AT FORK OF Rt. LAST HOUSE ON Rt

Tank		Capacity		Length of Lines		Fixtures	
Block	( )	1000	(✓)	225'	(✓)	No. of Baths	(1)
Precast	(✓)	1250	( )	250'	( )	Dishwasher	( )
		1500	( )	Other		Garbage Grdr.	( )
		Other				Other	

NOTIFY HEALTH DEPARTMENT AT LEAST EIGHT HOURS BEFORE TANK IS TO BE INSPECTED.

Final Inspection 12 - 28 1971 Approved (✓) Disapproved ( )

Remarks

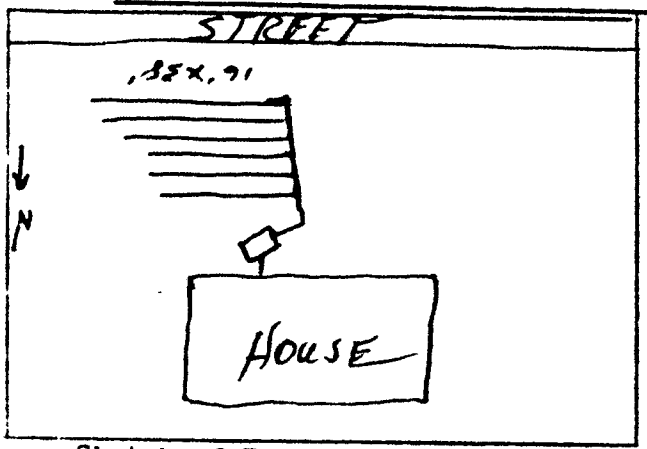

Sketch of Installation

o mile

Sanitarian