IREDELL COUNTY HEALTH DEPARTMENT

STATESVILLE 704-878-5305 MOORESVILLE 704-664-5281

IMPROVEMENT PERMIT / AUTHORIZATION TO CONSTRUCT / OPERATION PERMIT / EXISTING SYSTEM INSPECTION

PERMIT# 137762 PIN# 4732-56-2099 6084 704-957-0926 DATE 08/31/06

OWNER OR APPLICANT JERRY WRIGHT PHONE: Business 704-715-3235 Home 704-957-0761

ADDRESS 175 CARRIAGE CLUB DR. MOORESVILLE, NC 28117 (SERENE MEADOW TRAIL)

LOCATION HWY 21 SOUTH, (R) PAST PINEHAVEN RD., ON LONG GRAVEL DRIVE @ 2470 SHELTON AVE., NEAR END ON LEFT.

SUBDIVISION N/A BLOCK / SECTION — LOT — LOT AREA 1.0 ACRES SITE CLASS. PS DESIGN FLOW 360 GPD L.T.A.R. 0.275 GPD/FT²

Septic Tank: 1,000 Gallons: STB 760 Date 06/23/06
Pump Tank: ____ Gallons: PT ____ Date ____
Pump Make: ____ Model ____ Serial No. ____
Nitrification Field: No Fields 1 Square Feet EQ to 1310 Linear Feet 335'
No Lines 5 Trench Width 36" Max Trench Bottom Depth 30"

☒ New System ☐ Repair ☐ Expansion System Type: I (II) III IV V VI
System Description: 25% REDUCTION, GRAVITY
Repair System Description: 25% REDUC, PUMP
Maintenance Agreement Required: ☐ Yes ☒ No

☒ House/Mod. Home No. Bedrooms 3
☐ Mobile Home No. Persons ____
☐ Business No. Employees ____
☐ Other ____

Water Supply: ☒ Individual WELL ☐ Public ☐ Community


Gravel Depth N/A ☒ Gravity ☐ Pressure ☐ Slab ☒ Crawl Space ☐ Basement w/plumbing ☐ Basement wo/plumbing

Comments/Conditions: (1) MAXIMUM TRENCH BOTTOM DEPTH OF 30",

Comments/Conditions: *USED RED FILTER ? BRAND?

*SCALE!

INITIAL SITE SKETCH

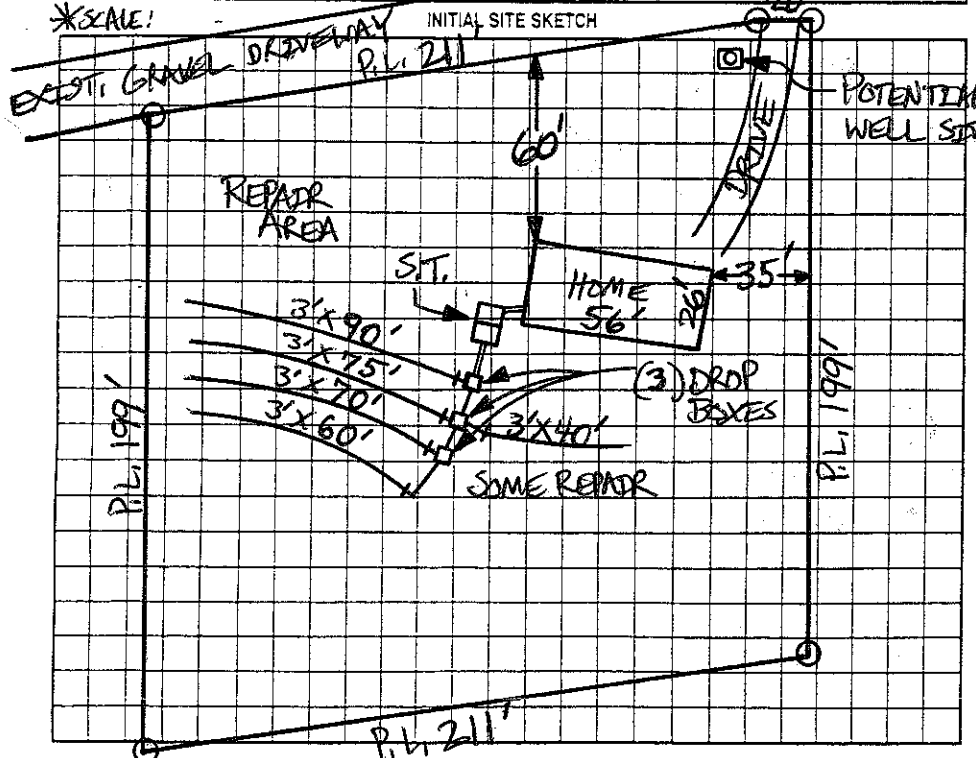

AS BUILT SKETCH

*INSTALLED AS SHOWN.

(SYSTEM INSTALLED BEFORE HOME SET UP)

Permit can be suspended or revoked if any false information is supplied toward securing the permit/any unauthorized changes are made to the site/any unauthorized changes are made in the installation of the system. Improvement Permit with plat valid without expiration ☐ Improvement Permit with site plan valid for sixty months ☒ Authorization to Construct is valid for a period equal to that of Improvement Permit – not to exceed sixty months.

Signed: [signature] date 8/31/06

Improvement Permit by: [signature] date 08/31/06

Authorization to Construct by: [signature] date 08/31/06

Installed by: ABEE'S GRADING

Operation Permit by: [signature] date 10/24/06

Existing System Inspection by: ____ date ____

HEALTH DEPT. COPY: WHITE OWNER COPY (FINAL): YELLOW OWNER COPY (INITIAL): PINK