IREDELL COUNTY HEALTH DEPARTMENT

Statesville Phone TR 3-7271 Mooresville Phone No. 664-5281

PERMIT TO INSTALL SEPTIC TANK

Permit No. 241 Permit Date 3-28 1973

Owner J.C. Clonts Builder Address Statesville N.C.

Installed By Lackey Bro Address Stony Point N.C.


Location of Property Hwy 21 S. Below Iredell Memorial Park Cemetary T.R. on Rd 1468 Bear to left at forks of road House on R. at end of strut.

Tank		Capacity		Length of Lines		Fixtures	
Block	( )	1000	( )	225'	( )	No. of Baths	(2)
Precast	(✓)	1250	(✓)	250'	( )	Dishwasher	(✓)
		1500	( )	Other 255		Garbage Grdr.	(✓)
		Other				Other	

NOTIFY HEALTH DEPARTMENT AT LEAST EIGHT HOURS BEFORE TANK IS TO BE INSPECTED.

Final Inspection 3.28 1973 Approved (✓) Disapproved ( )

Remarks Well 76' away from system

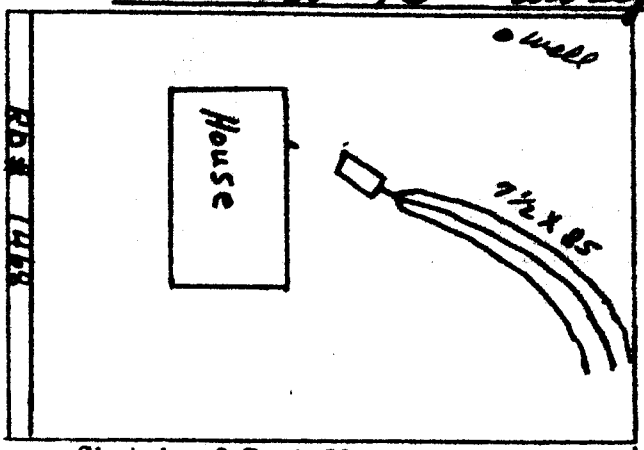

Sketch of Installation

Tank & lines are deep due to stub out.

E. A. Stevenson

Sanitarian